



T.13S., R.30E., W.M.

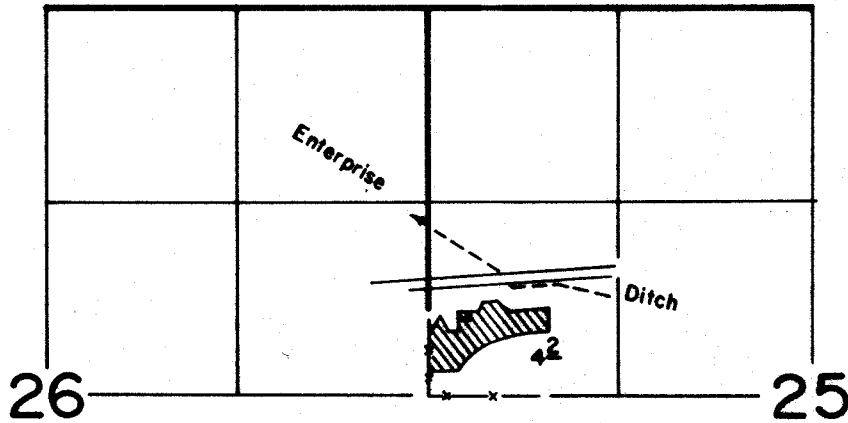

T.13S., R.31E., W.M.

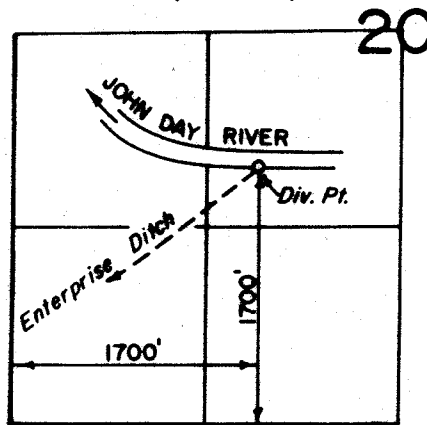

FINAL PROOF SURVEY UNDER

Application No. 52123 Permit No. 39262
IN NAME OF

ROTHELLE HERBURGER

Surveyed JUNE 17, 1980, by *[Signature]*