


T.18S.,R.10W.,W.M.

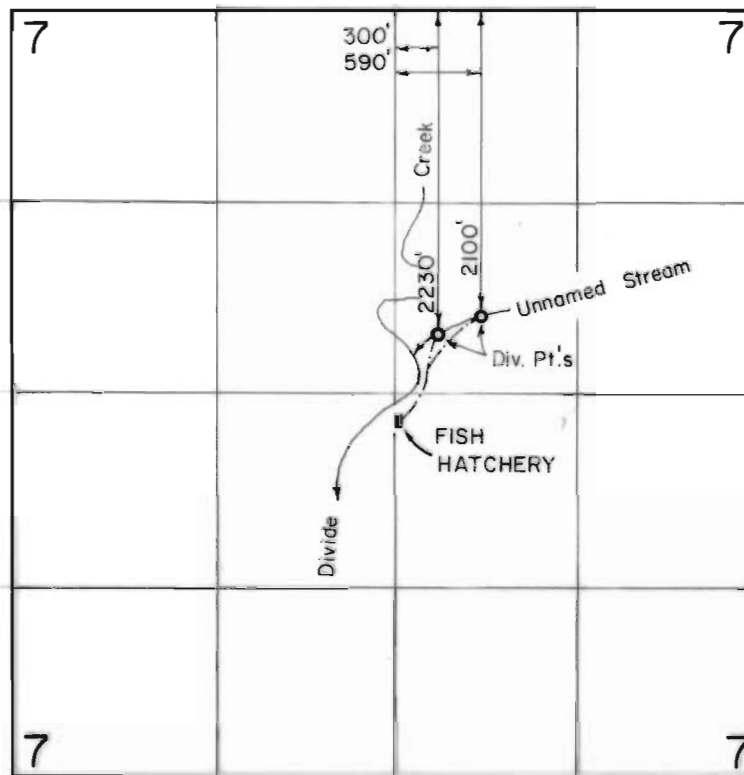

FINAL PROOF SURVEY
UNDER

Application No. 52776 Permit No. 39725
IN NAME OF

CERATODUS FISHERIES, CO.

Surveyed MAY 14, 1980, by *[Signature]*