
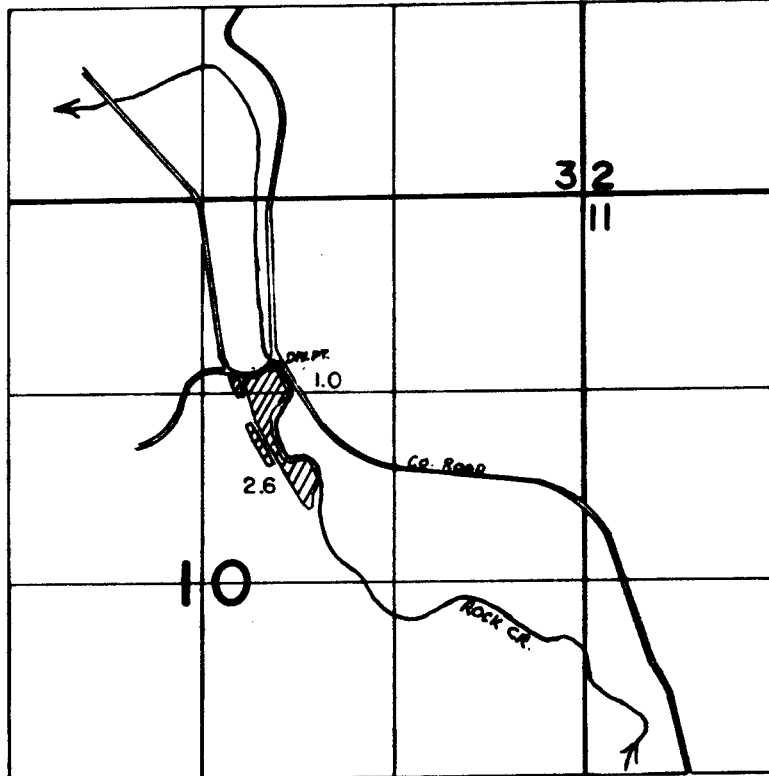


P-40235
56641

T. 1 S., R. 21 E., W. M.

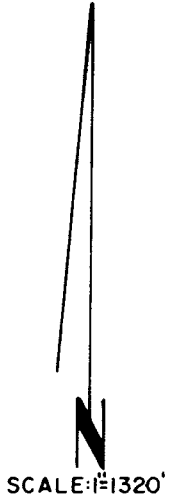

DIV. PT. LOCATED 1160' S. AND 470' E. FROM N. 1/4 COR. SEC. 10

FINAL PROOF SURVEY UNDER

Application No. .53927.. Permit No. .40235.....
IN NAME OF

.....DALE W. WILCKE.....

Surveyed APRIL 8..... 1985., by X. L. CHURCH.....