




T. 2 S., R. 3 E., W.M.

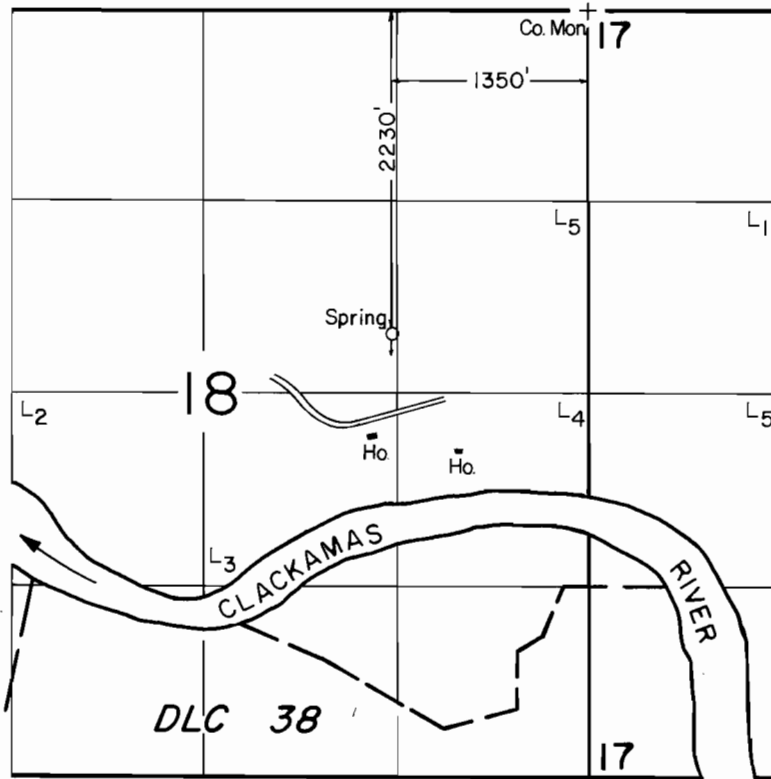

SCALE: 1" = 1320'

FINAL PROOF SURVEY
UNDER

Application No. 54158... Permit No. 40543.....
IN NAME OF

S. WINIFRED McINTYRE & STEVEN B. & MARY OLLIE

Surveyed SEPT. 2... 1986, by T. WARREN.....