


T.16S., R.6W., W.M.

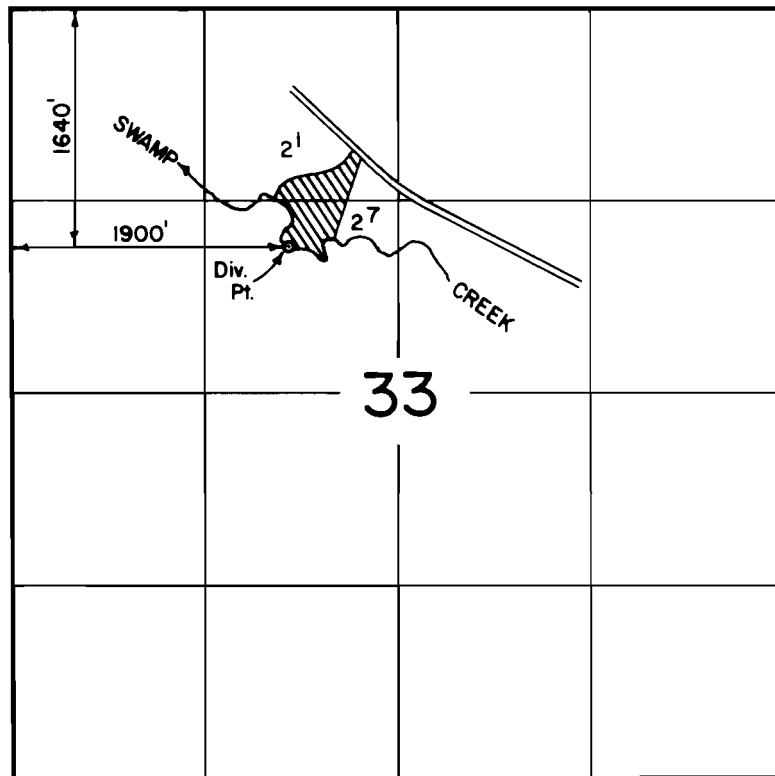

FINAL PROOF SURVEY
UNDER

Application No. 54391.. Permit No. 40760....
IN NAME OF

JOHN F. BAXTER, JR.

Surveyed MAY 8, 1980, by *dlb*