


P-40844
56643

T. 1 S., R. 21 E., W.M.

SCALE: 1"=1320'

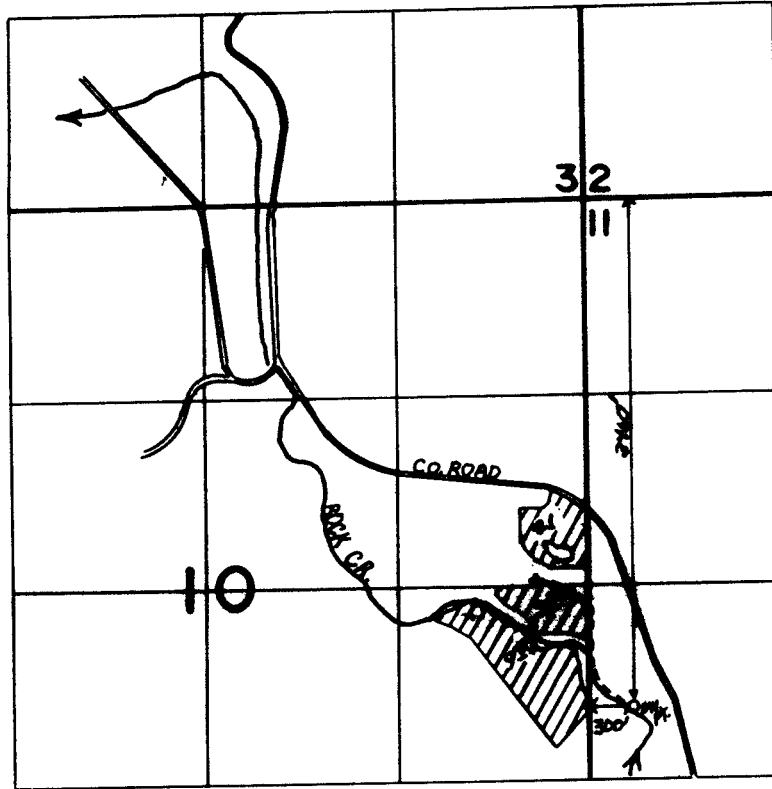

FINAL PROOF SURVEY
UNDER

Application No. ~~54442~~ Permit No. 40844.....

IN NAME OF

MATTIE B. ALLEN

Surveyed APRIL 8, 1985, by Y.L. CHURCH.....