


T.15S.,R.46E.,W.M.

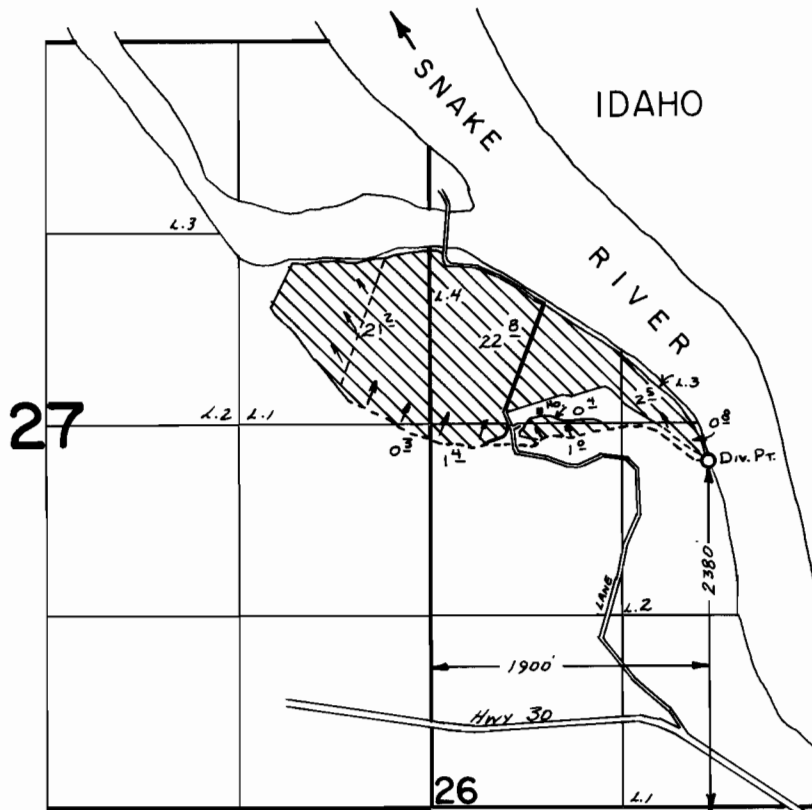

FINAL PROOF SURVEY
UNDER

Application No. 55100... Permit No. 41383.....
IN NAME OF

.....**T. H. CATTLE COMPANY**.....

Surveyed Aug. 18... 1983., by L. M. TOLL.....