


P-42166
56650

T. 13S., R. 30E., W.M.

SECTION 32

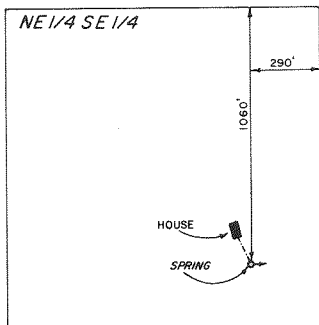

SCALE 1" = 400'

FINAL PROOF SURVEY
UNDER

Application No. 56125, Permit No. 42166...

IN NAME OF

NICHOLAS LEE BROCKWAY

Surveyed JUNE 13, 1980, by dB Brown...

PTS-1980-A