


T.28S., R.13 W., W.M.

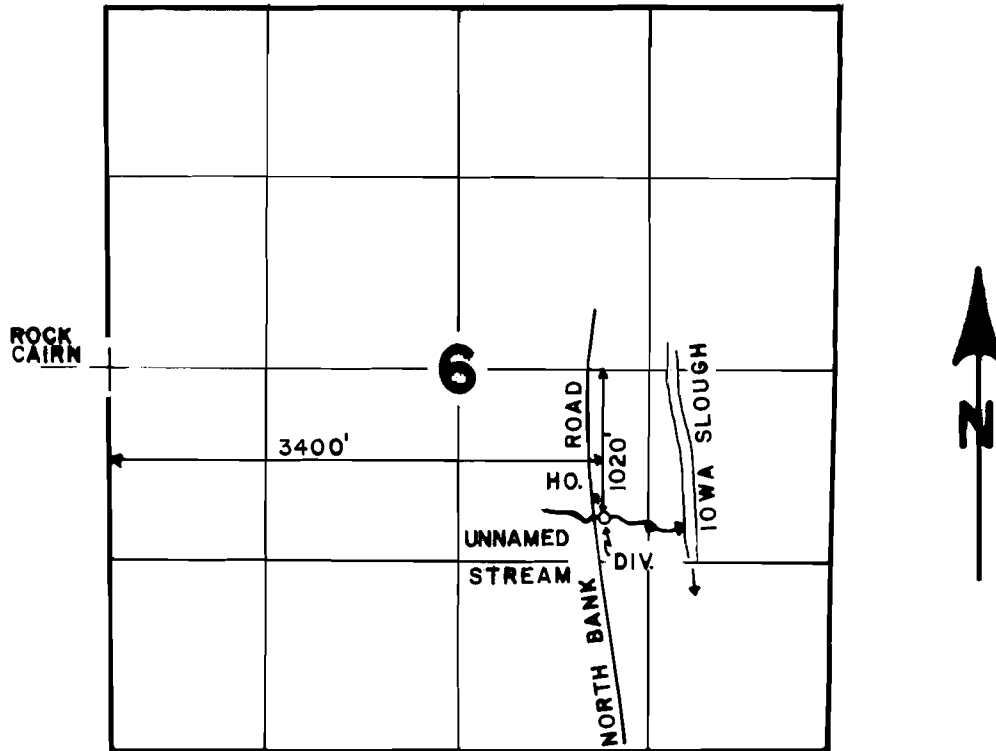

SCALE: 4" = 1 MILE

FINAL PROOF SURVEY
UNDER

Application No. 57055 Permit No. 42829
IN NAME OF

EDWARD A. SUMMERS

Surveyed SEPT. 11, 1985, by J.M. SCHMORDE