


T.9S. R.4W., W.M.

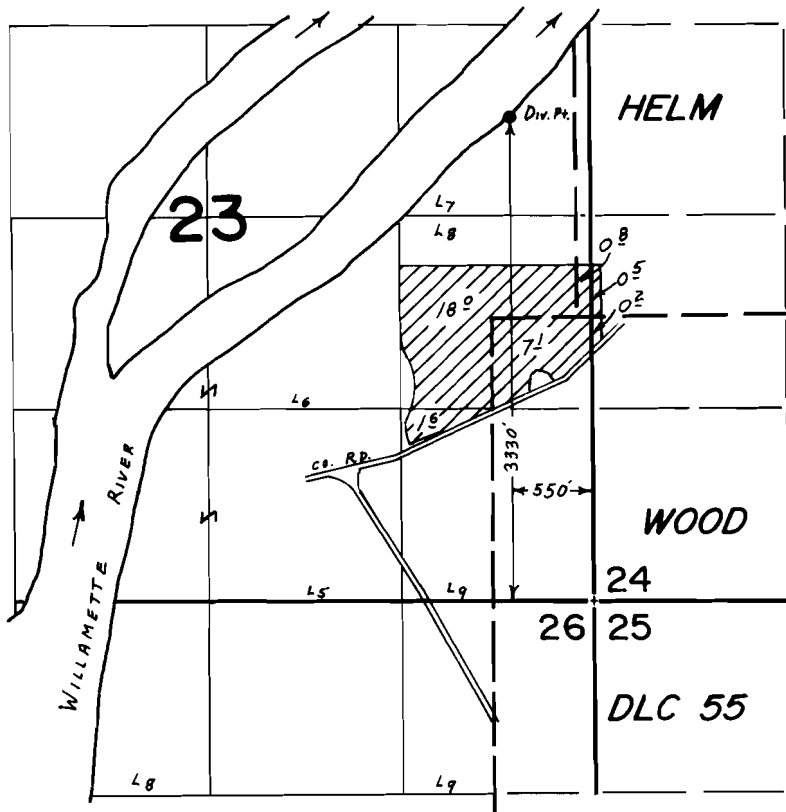

FINAL PROOF SURVEY UNDER

Application No. 55371.... Permit No. 43175.....
IN NAME OF

..... WELDON FAMILY TRUST

Surveyed MAY...29.. 1979., by L. H. NUNN.....