


T. 26 S., R. 3 W., W.M.

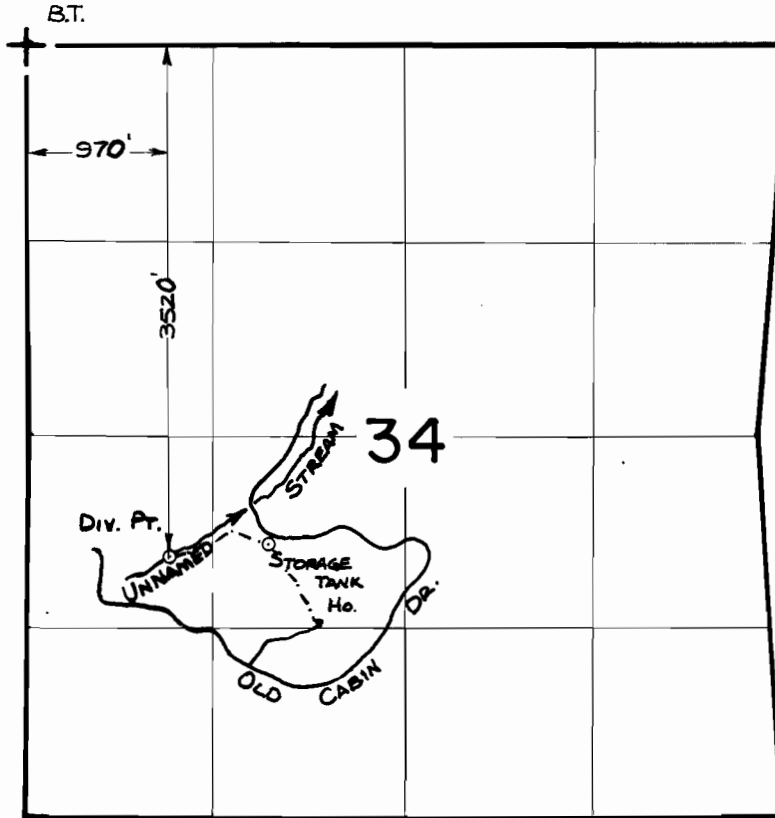

SCALE : 4" = 1 MILE

FINAL PROOF SURVEY
UNDER

Application No. 57403. Permit No. 43355...
IN NAME OF

.....**BRUCE J. WARE**.....

Surveyed OCT. 2, 1986, by J.M. SCHMORDE