


T.11S. R.8W. W.M.

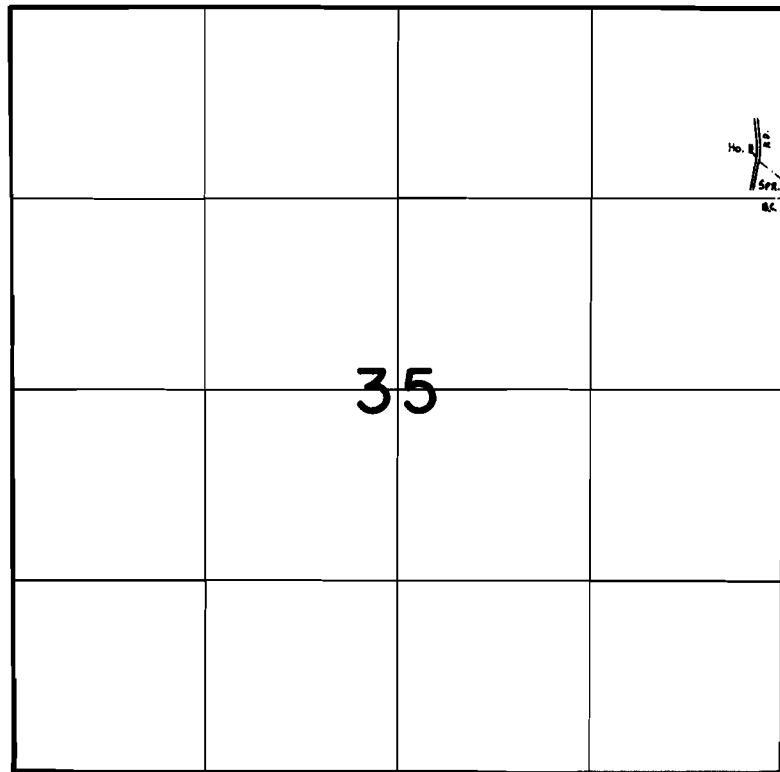

SPRING LOC: 90'N. $\frac{1}{2}$ 10'E. fr. S.E. COR. of NE $\frac{1}{4}$ NE $\frac{1}{4}$ of Sec 35.

FINAL PROOF SURVEY
UNDER

Application No. 58129 Permit No. 43810
IN NAME OF

EUGENE M. COOPER, JR.

Surveyed June 12, 1979, by C. L. HUGHES