

Application No. 58504  
Permit No. 44157




**RECEIVED**

APR 09 1979

WATER RESOURCES DEPT.  
SALEM, OREGON

T17S

3

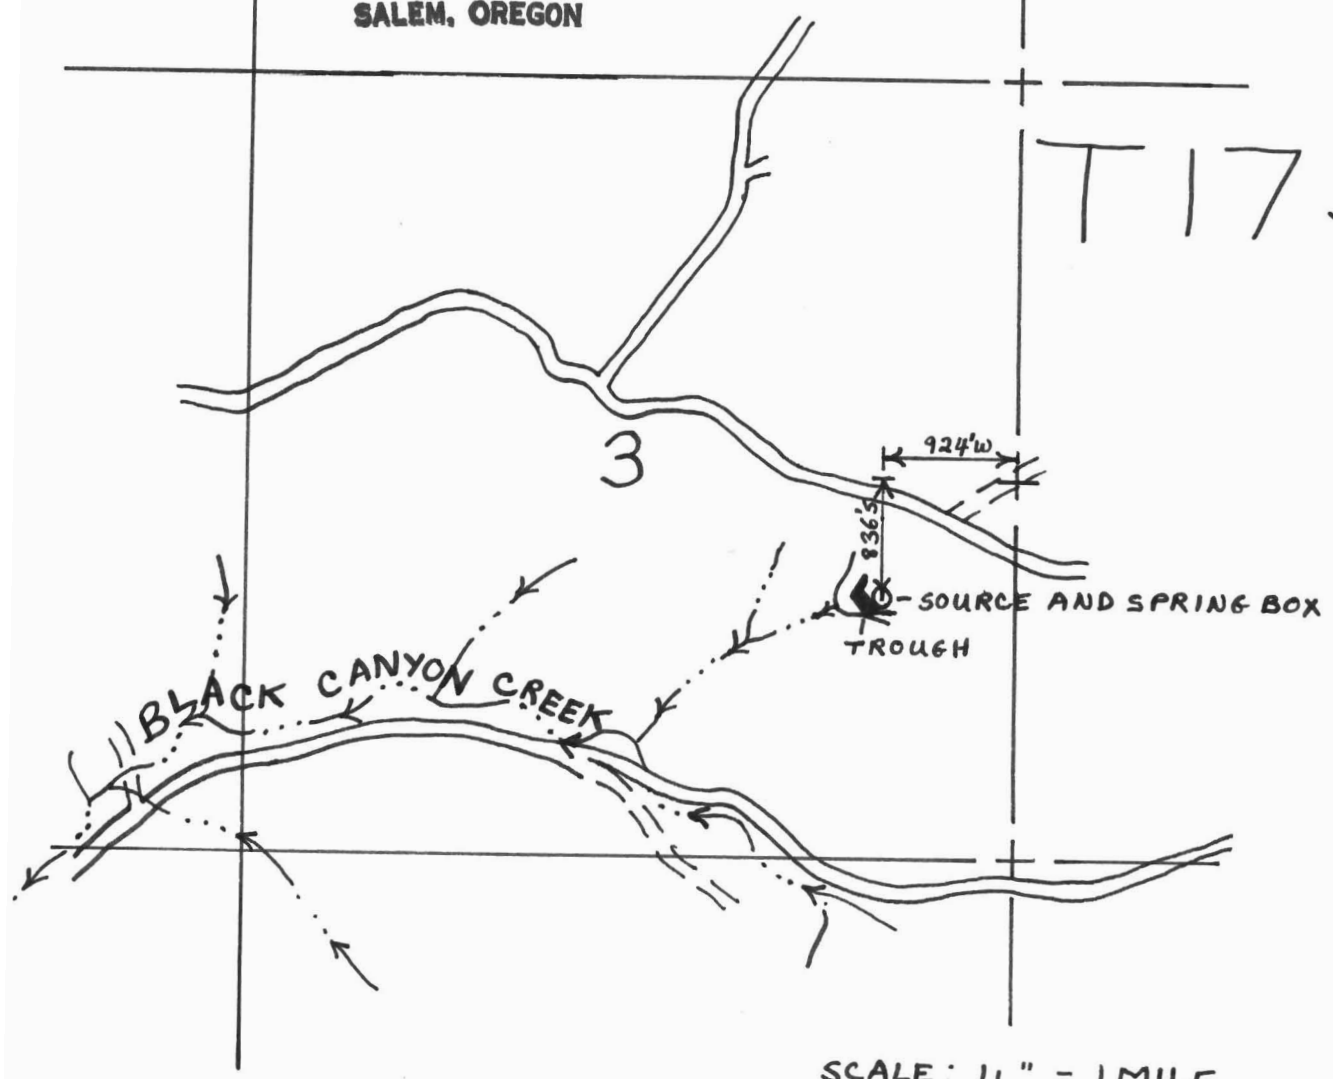

SCALE: 4" = 1 MILE

R34E