


T. 19 S. R. 12 W. W. M.

SALEM, OREGON
WATER RESOURCES DEPT.

JUN 8 1979

RECEIVED

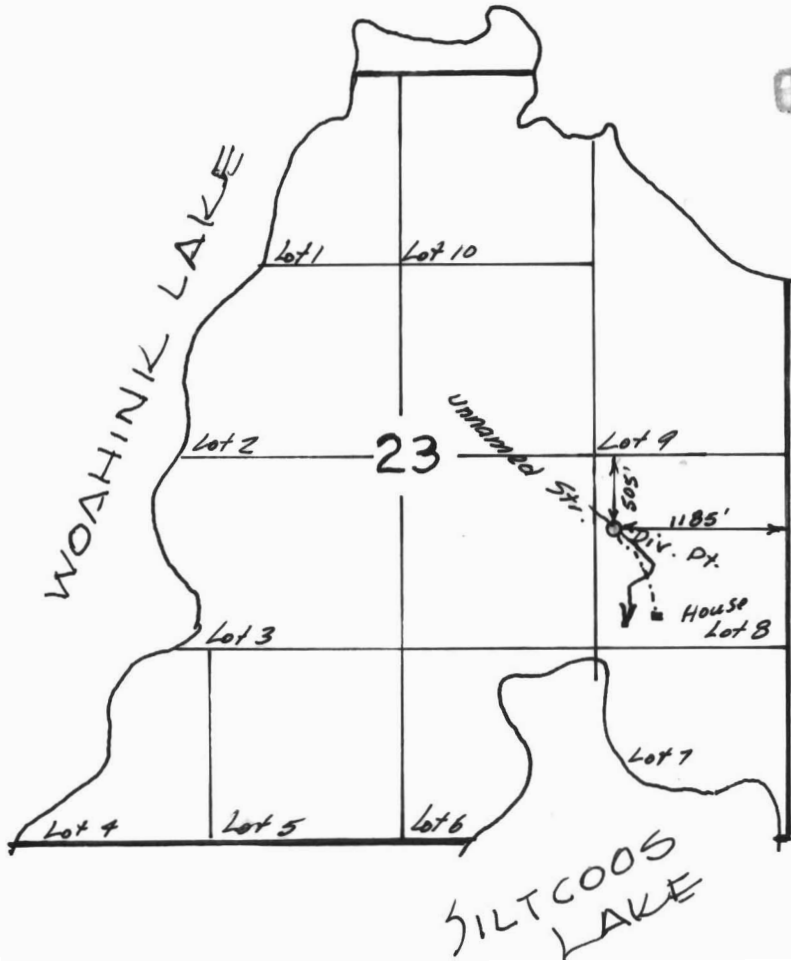

THIS MAP PREPARED BY:

R.H.

FROM INFORMATION FURNISHED BY
THE APPLICANT.

Application No. 58525
Permit No. 44187