




T. 2 S., R. 2 & 3 E., W.M.

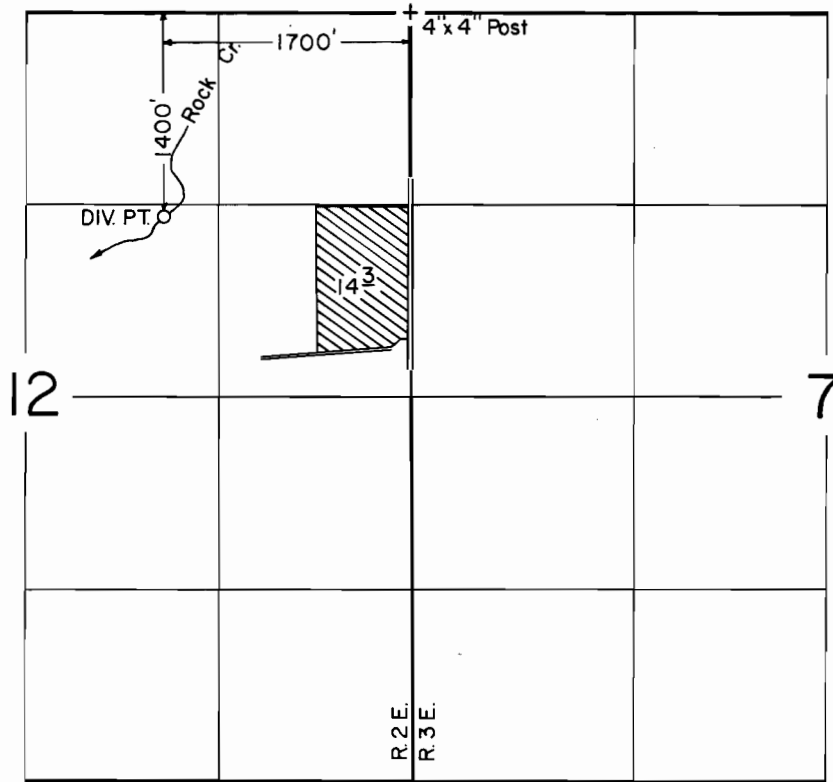

SCALE: 1" = 1320'

FINAL PROOF SURVEY
UNDER

Application No. 58832.. Permit No. 44666.....
IN NAME OF

.....LEE SCHWEIZER.....

Surveyed AUG. 27... 1986, by T. WARREN.....