


T. 13S., R. 32E., W.M.

SCALE: 1" = 1320'

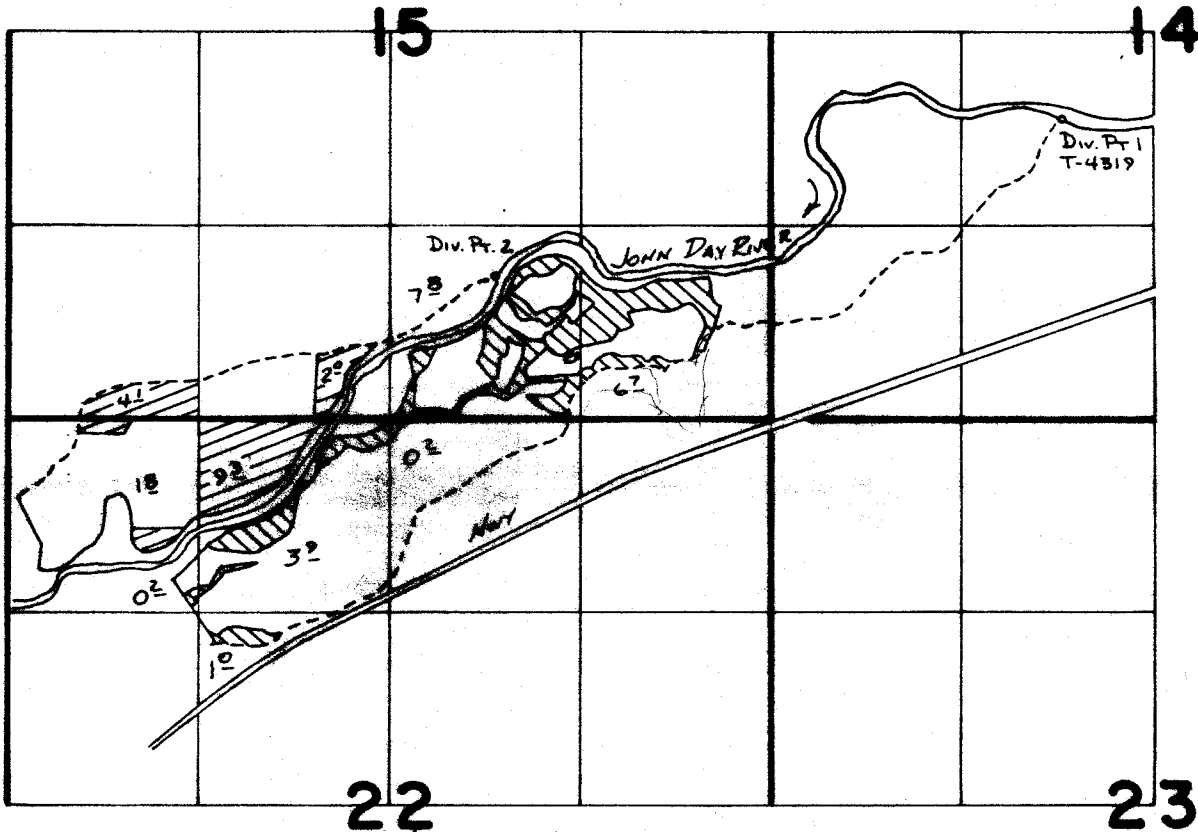

Div. Pt. 1 Loc: 2040 N. + 2020' E. }
 Div. Pt. 2 Loc: 970' N. + 1910' W. } From SE Cor. Sec 15

CHECK CERTIFICATE 56662

P.O.D. MIS-LABELLED

#1 SHOULD BE #2

#2 SHOULD BE #1

 Div. Pt. 2

 Div. Pt. 1

FINAL PROOF SURVEY UNDER

TRANSFER 4319

Application No. **59463** Permit No. **44742**

IN NAME OF

CLYDE HOLLIDAY

Surveyed **3-22** 19**86**, by **h.M. Tamm**