




T. 4 S., R. 2 E., W.M.

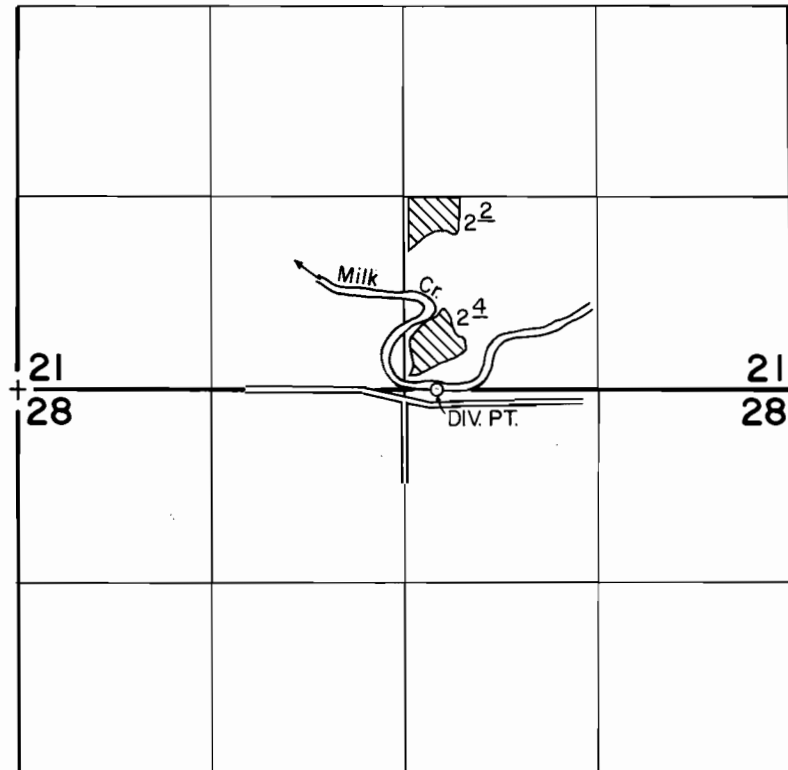

DIV. PT. LOC: 10' N. & 2870' E. FROM S.W. CORNER SECTION 21

SCALE: 1" = 1320'

FINAL PROOF SURVEY UNDER

Application No. 59885 Permit No. 45018
IN NAME OF

HANS ZENTHOEFER

Surveyed JULY 7, 1986, by T. WARREN