


T.25 S., R.7 W., W.M.

SECTION 29

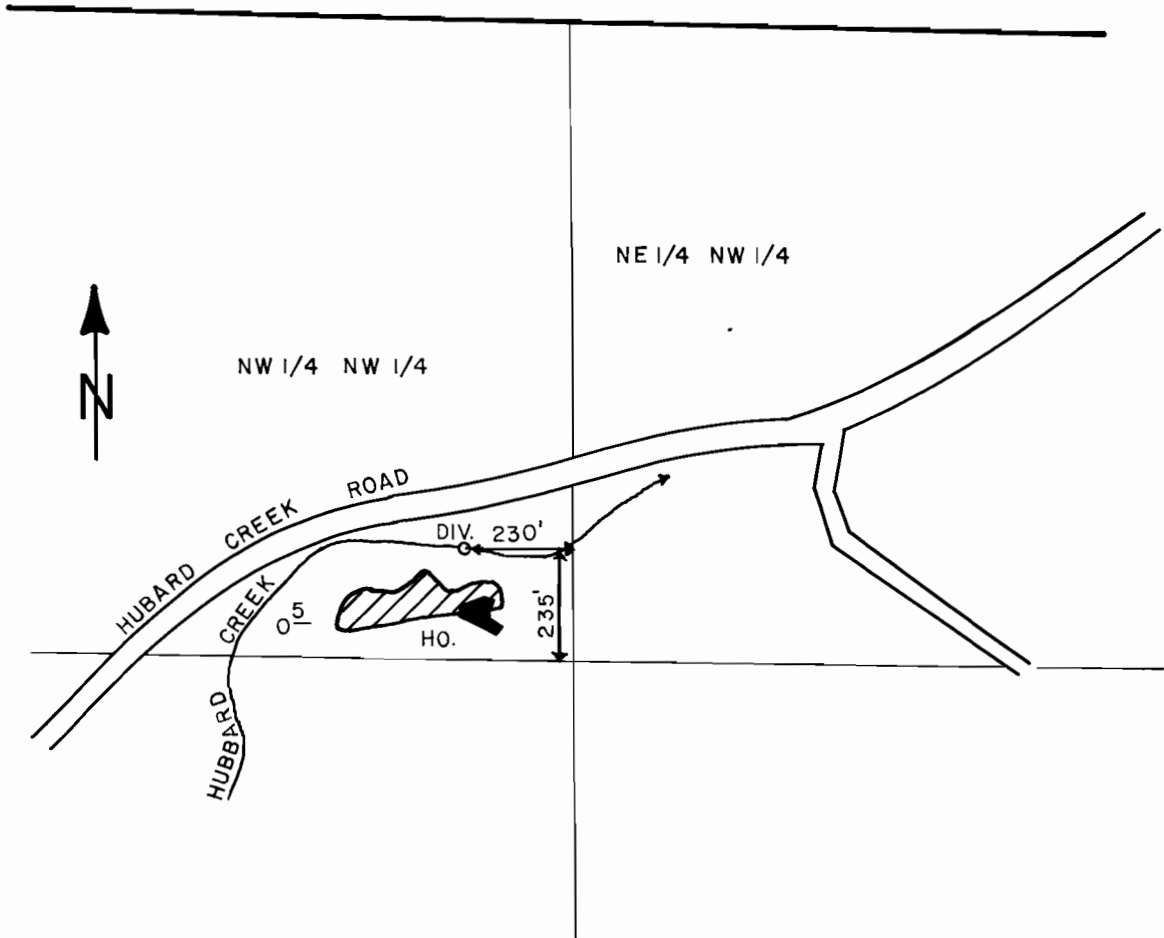

SCALE 1" = 400'

FINAL PROOF SURVEY UNDER

Application No. 60176 Permit No. 45143
IN NAME OF

JERRY L. & BETTY L. LAMB

Surveyed AUG. 8 1986, by J. M. SCHMORDE