


T. 37 S., R. 14 W., W.M.

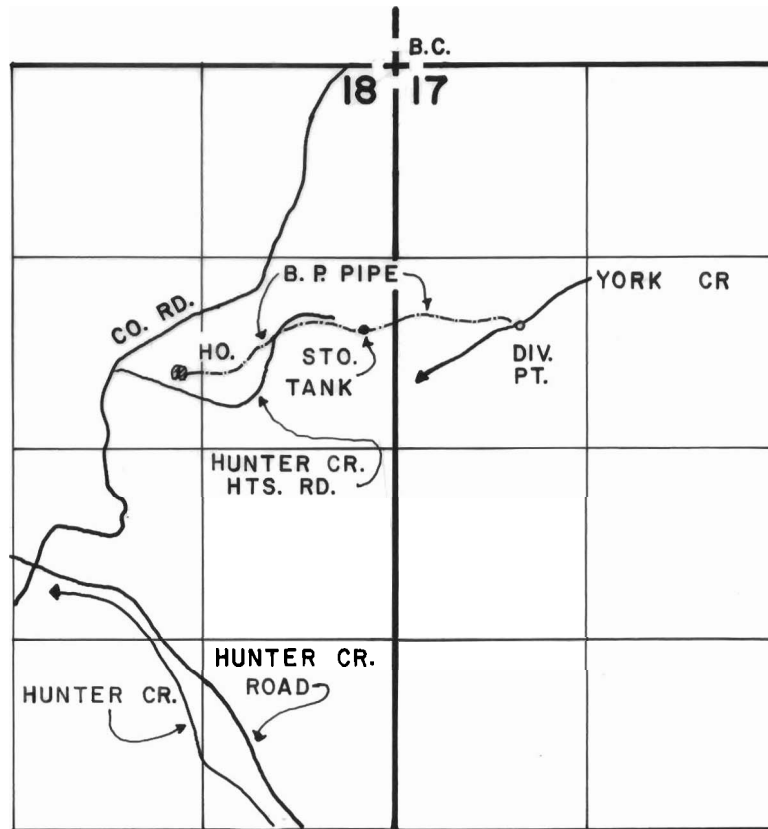

DIV. PT. LOCATED 1775' S. & 850' E. FROM NE COR. SEC. 18.

SCALE: 4" = 1 MILE

FINAL PROOF SURVEY
UNDER

Application No. **60726** Permit No. **45386**....
IN NAME OF

.....**ALBERT R. CLAY**.....

Surveyed **SEP. 25** 19**85**, by **J.M. SCHMORDE**