


T. 26 S., R. 3 W., W.M.

SECTION 10

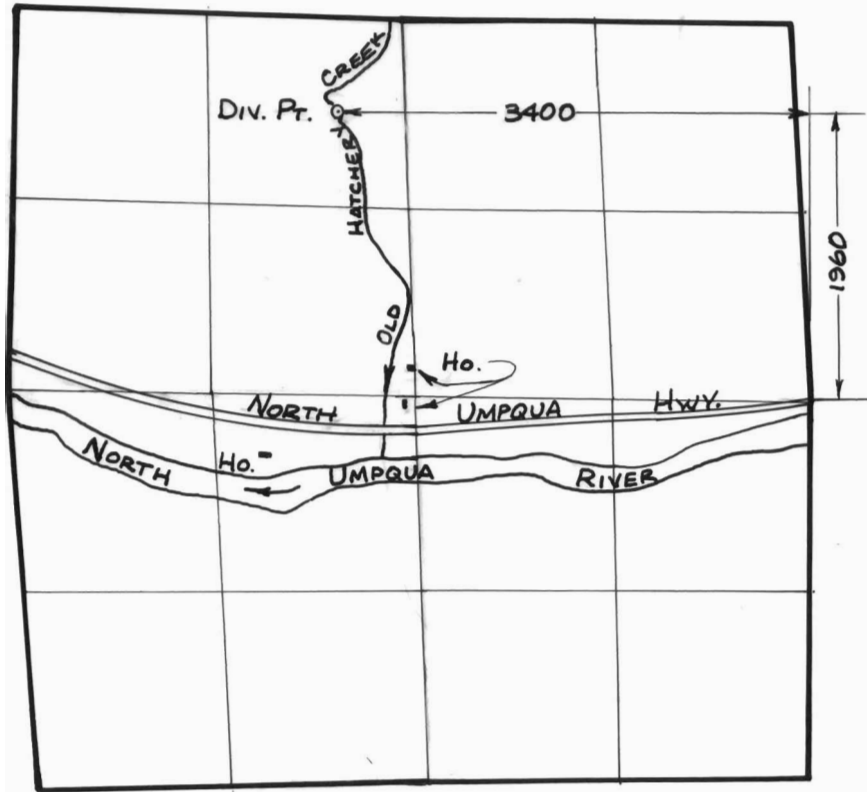

SCALE: 4" = 1 MILE

FINAL PROOF SURVEY UNDER

Application No. ...~~61271~~... Permit No.~~45604~~...
IN NAME OF

ALBERT DEBERNARDI, RAELENE DEBERNARDI, GARY KENNADAY

Surveyed ..SEPT..5, 19.85., by ..J.M.SCHMORDE..