


T. 39S., R. 14 W., W.M.

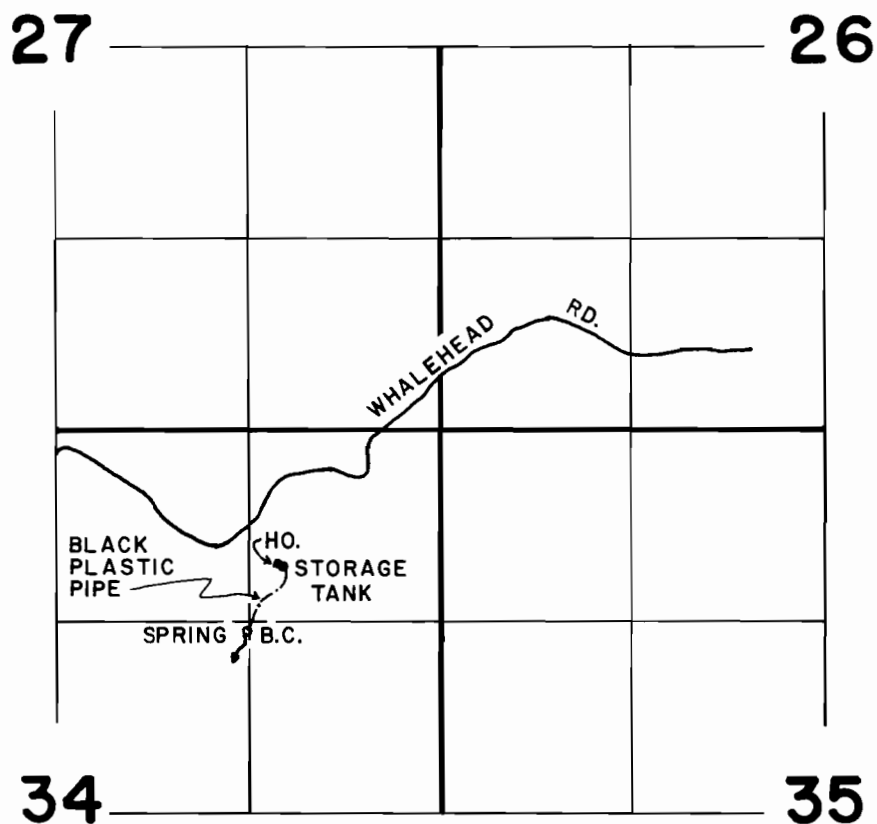

DIV. PT. LOCATED 50' S. & 10' W. FROM NE 1/16 COR. SEC. 34.

SCALE: 4" = 1 MILE

FINAL PROOF SURVEY

UNDER

Application No. 60180 Permit No. 45841
IN NAME OF

BURRELL S. BABB

Surveyed OCT. 10, 1985, by J.M. SCHMORDE