


T. 37 S., R. 14 W., W.M.

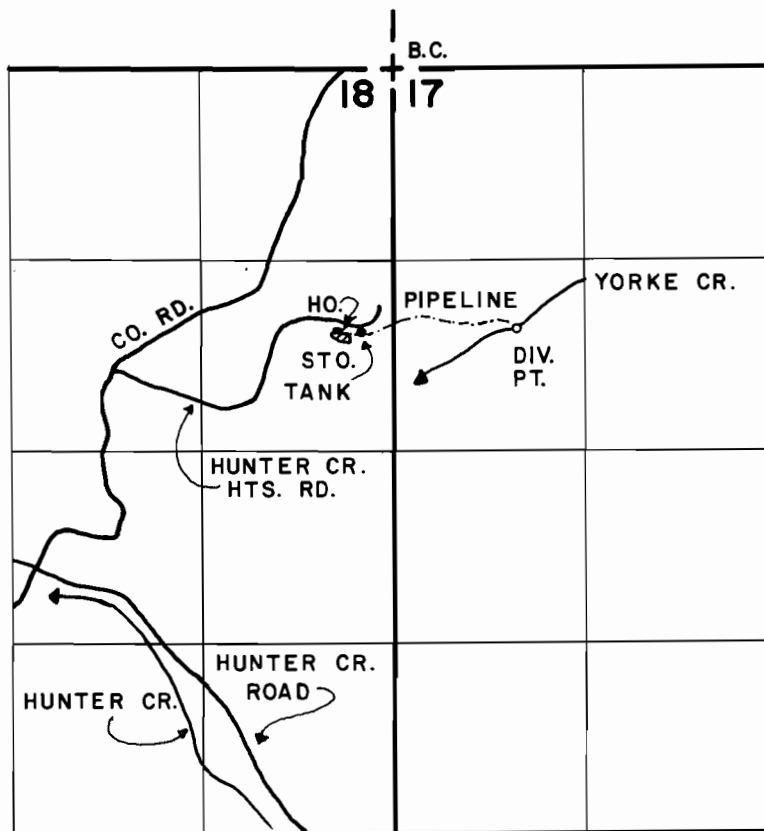

DIV. PT. LOCATED 1775' S. & 850' E. FROM NE COR. SEC. 18.

SCALE: 4" = 1 MILE

FINAL PROOF SURVEY
UNDER

Application No. 60966 Permit No. 46203
IN NAME OF

MARK MITCHELL

Surveyed SEP. 25 1985, by J.M. SCHMORDE