


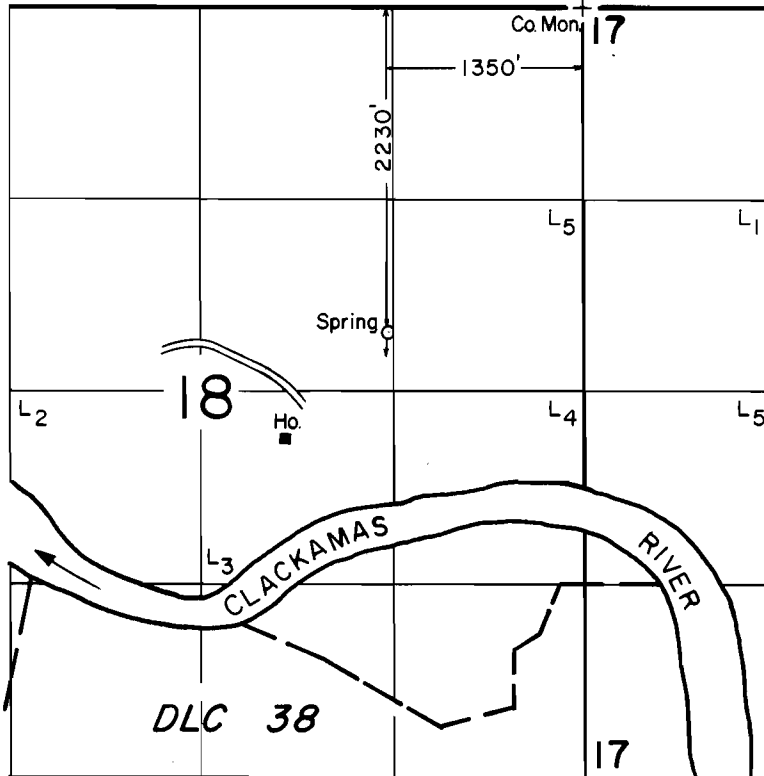

T. 2 S., R. 3 E., W.M.



SCALE: 1" = 1320'

FINAL PROOF SURVEY
UNDER

Application No. 62963. Permit No. 46629.....
IN NAME OF

.....M. MILLICENT WILLIAMSON.....

Surveyed SEPT. 2, 1986, by T. WARREN.....