


RECEIVED

10/05/87

WATER RESOURCES DEPT
SALEM, OREGON

T. 35 S., R. 6 W., W.M.

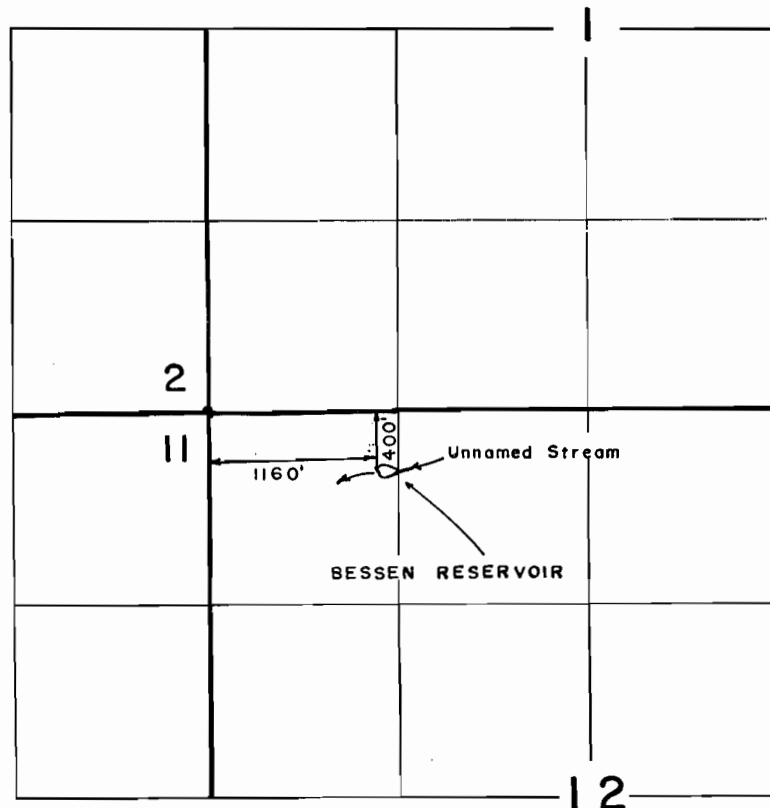

SCALE: 1" = 1320'

FINAL PROOF SURVEY
UNDER

R-62442 R-8513

Application No. ~~62443~~ Permit No. ~~47073~~
IN NAME OF

ROBERT BESSEN

Surveyed JUL 16, 1986, by B. S. JAMES