


T. 35 S., R. 6 W., W.M.

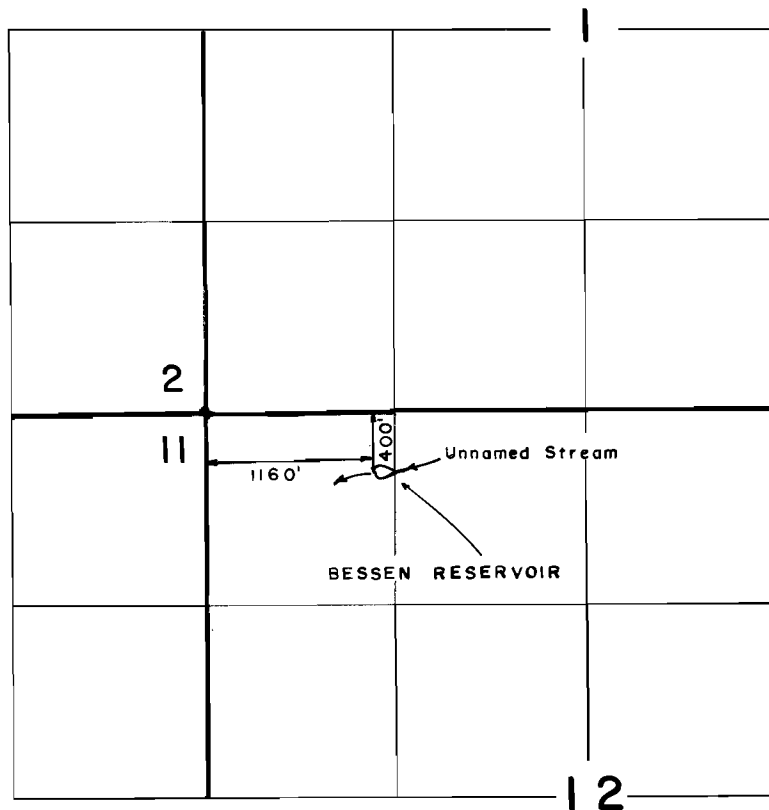

SCALE: 1" = 1320'

FINAL PROOF SURVEY
UNDER

R-62442 R-8513

Application No. **62443** Permit No. **47073**
IN NAME OF

ROBERT BESSEN

Surveyed JUL 16 1986, by B. S. JAMES.