




T.16 S., R.5 W., W.M.

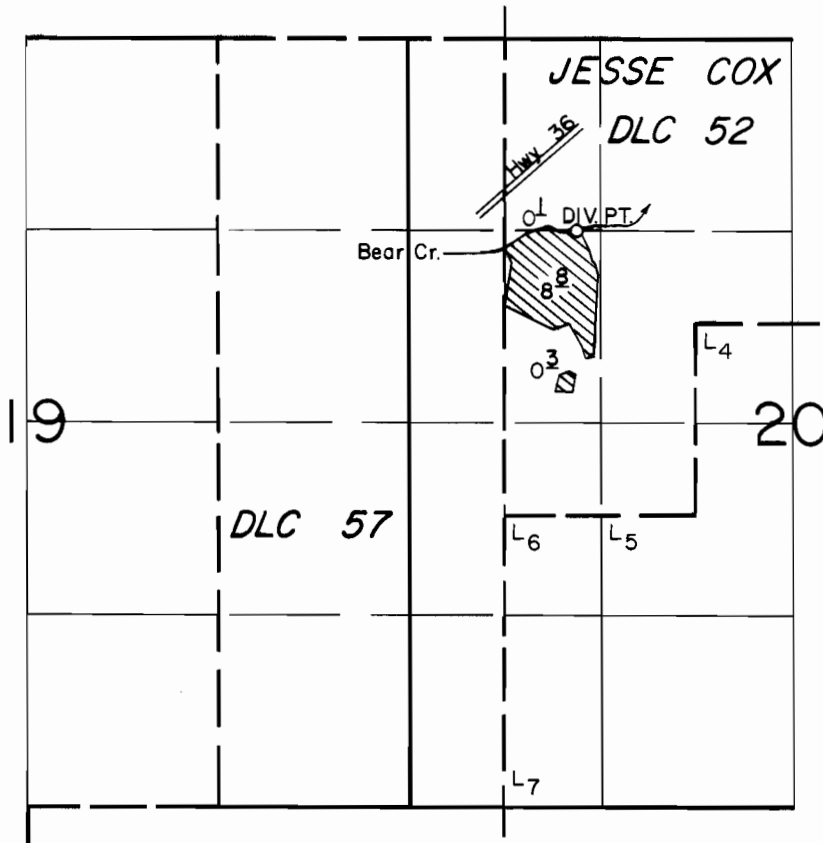

DIV. PT. LOC.: 1310' S. & 1150' E. FROM NW. CORNER SECTION 20

SCALE: 1" = 1320'

FINAL PROOF SURVEY UNDER

Application No. 64477... Permit No. 47144.....
IN NAME OF

JOHN RILEY

Surveyed OCT. 14... 1986, by T. WARREN