T.29S., R.6W., W.M.

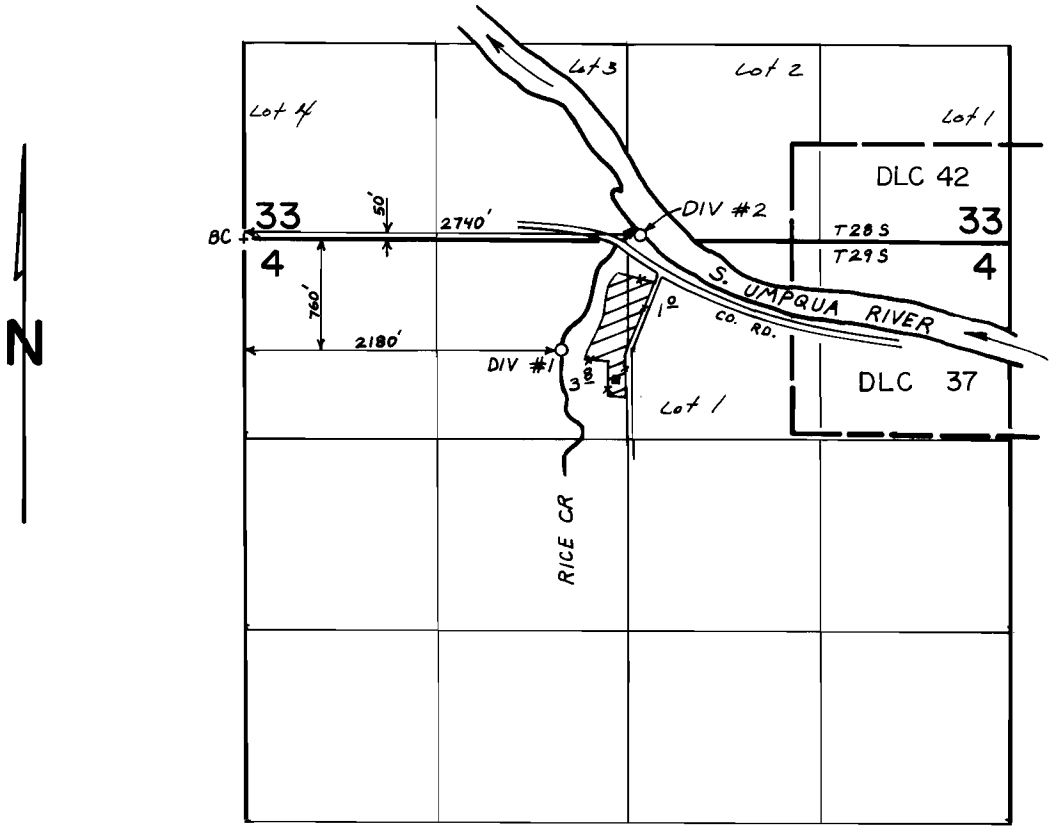

SCALE: 4" = 1 mile

FINAL PROOF SURVEY
UNDER

Application No. 64971 Permit No. 47462
IN NAME OF

WILLIAM A. & ROLINDA H. LEE

Surveyed DEC 15 19.83, by L. Cashion

41019-278 112A LEC