




T. 2 S., R. 3 E., W.M.

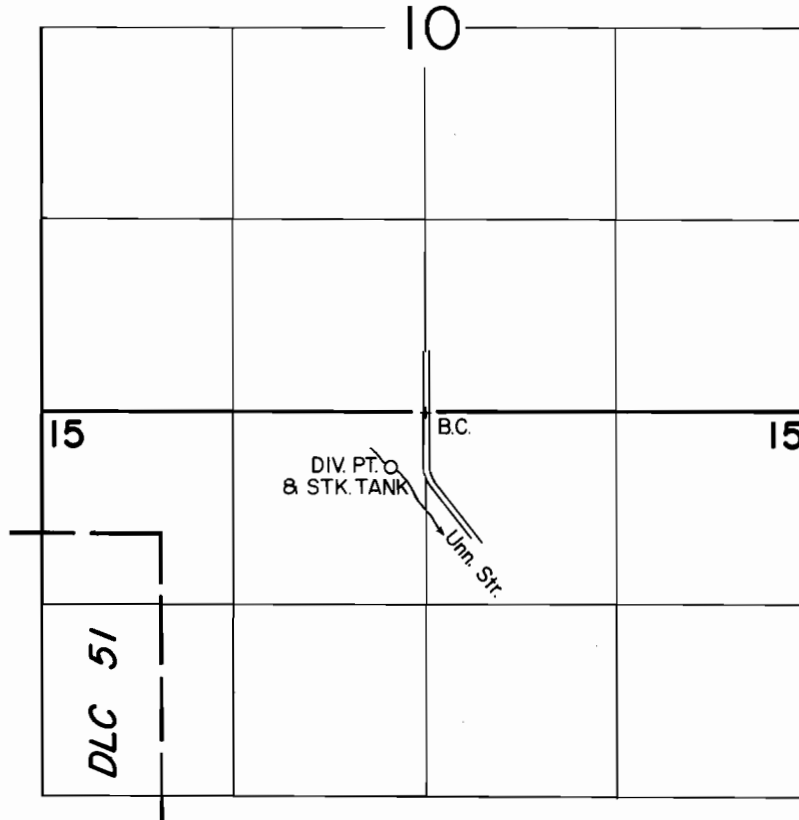

DIV. PT. LOC.: 380' S. & 240' W. FROM N 1/4 CORNER SECTION 15

SCALE: 1" = 1320'

**FINAL PROOF SURVEY**  
UNDER

Application No. 65043.. Permit No. 47535.....  
IN NAME OF

**RICHARD H. & DONNA LEE DOWERS**

Surveyed AUG. 28. 1986., by T. WARREN.....