


T. 19 S., R. 44 E., WM

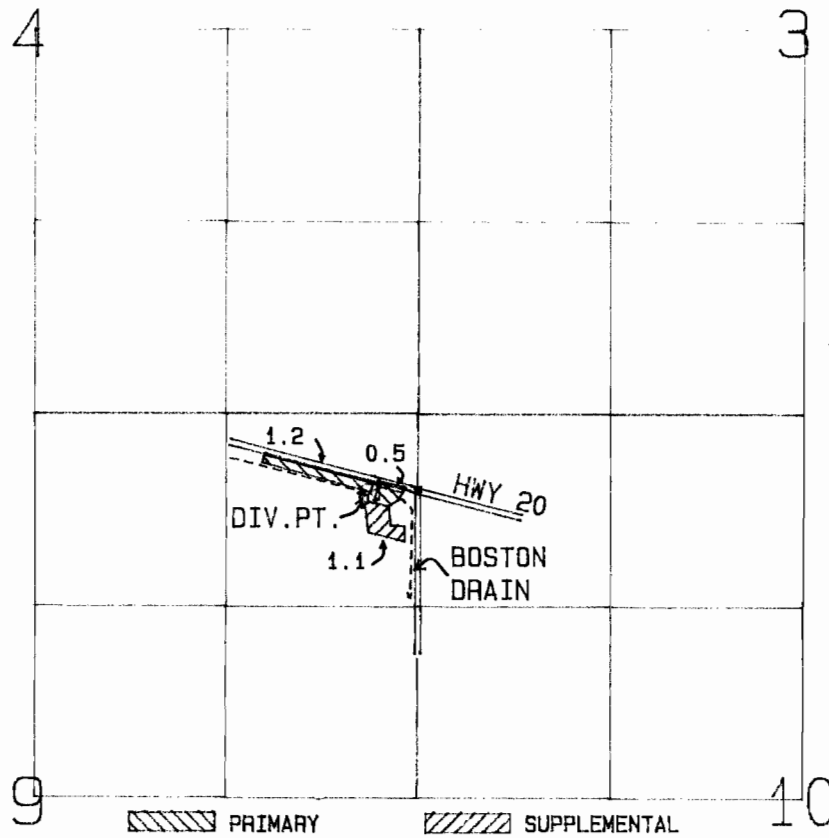

DIVERSION LOCATED: 540 FT SOUTH AND 340 FT WEST FROM  
THE NORTHEAST CORNER SECTION 9.

SCALE 1 IN = 1320 FT

FINAL PROOF SURVEY  
UNDER

APPLICATION NO.: 65228 PERMIT NO.: 47879

IN THE NAME OF

FRANK & JOYCE ELFERING

SURVEYED APRIL 17, 1986

BY: L. M. TOLL

COMPUTER DRAFTED: JCL  
PHOTO 41045-478-62L