


T. 6N., R. 35E., W. M.

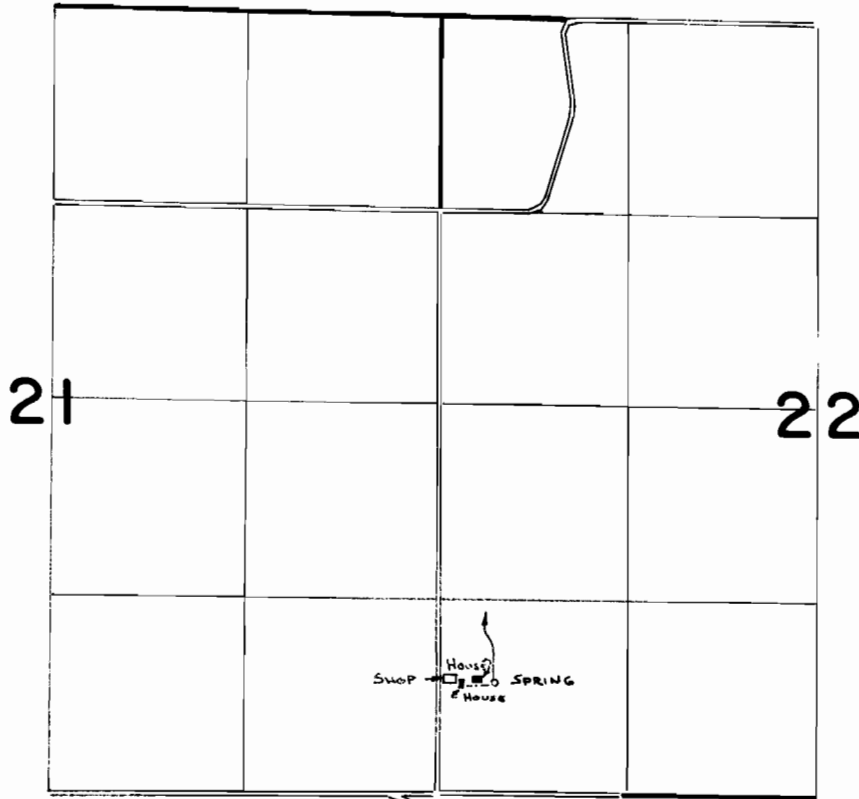

SPRING Loc: 750' N. & 390' E. FROM SW COR. SEC. 22

FINAL PROOF SURVEY
UNDER

SCALE: 1" = 1320'

Application No. **65271**... Permit No. **48200**...
IN NAME OF

.....**CHARLES CRUTHERS**.....

Surveyed ...**4-25**... **1984**, by **V.L. Church**.....