


T.24S., R.7 W., W.M. SECTION 21

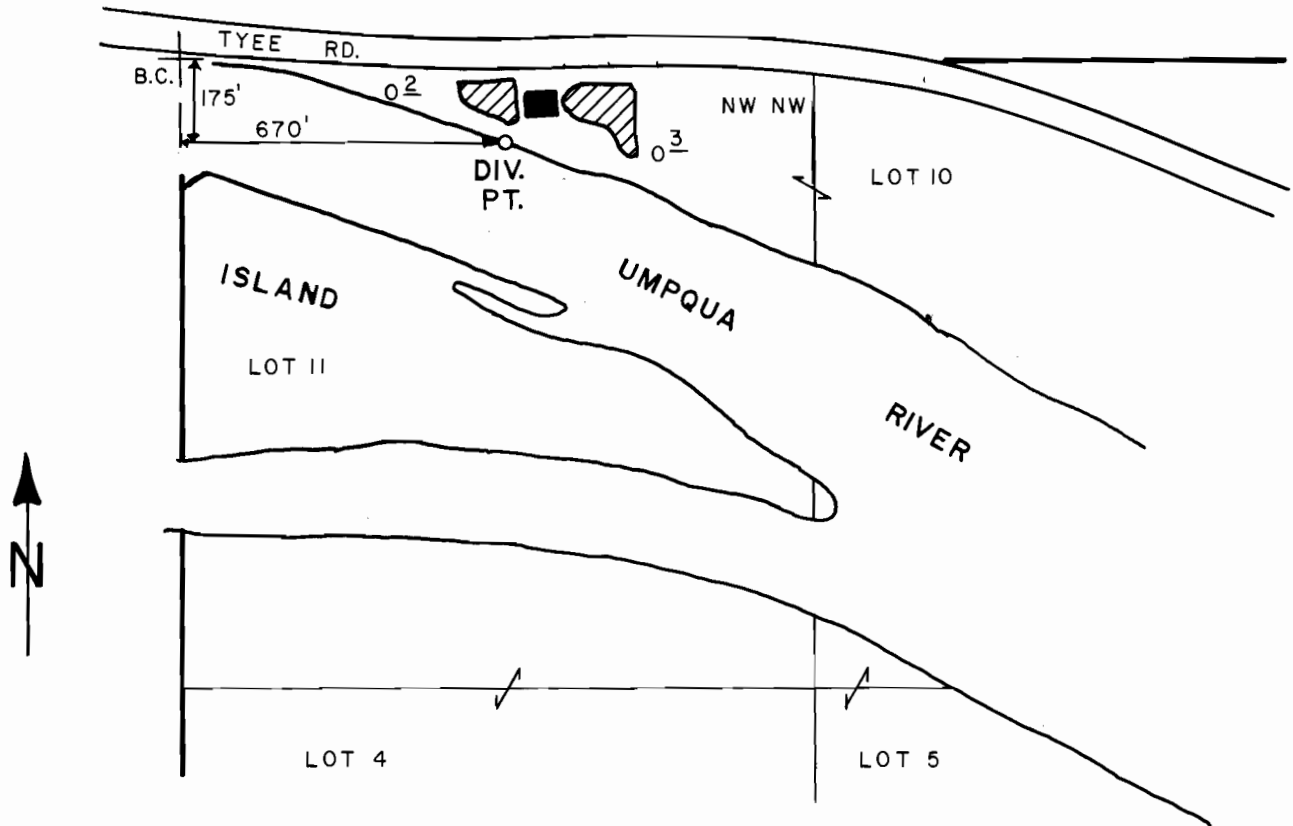

SCALE: 1" = 400'

FINAL PROOF SURVEY UNDER

Application No. 67900... Permit No. 48220...
IN NAME OF

RICHARD H. BAIRD

Surveyed AUG. 19, 1986, by J. M. SCHMORDE