




T. 3 S., R. 1 W., W.M.

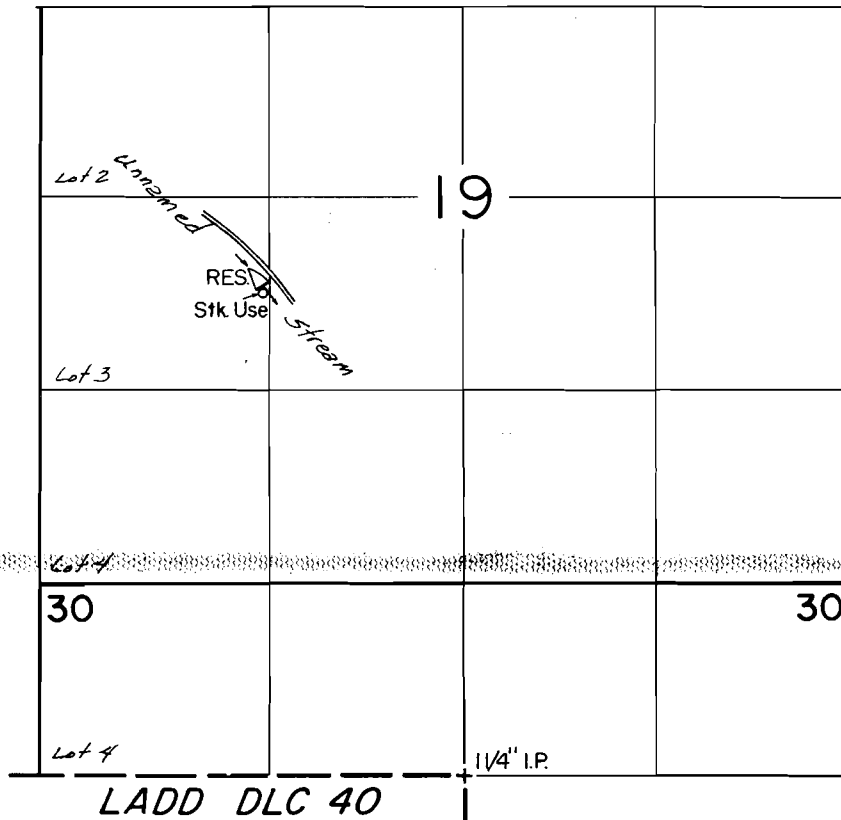

DIV. PT. LOC.: 3400' N. & 1400' W. FROM N.E. CORNER LADD DLC 40

SCALE: 1" = 1320'

FINAL PROOF SURVEY UNDER

R-60127

R-8197

Application No. 68225... Permit No. 49175.....
IN NAME OF

PAUL V. & CAROLYN H. EVERS.....

Surveyed JULY 16, 1986, by T. WARREN.....