


T. 8 S., R. 3 W., W.M.

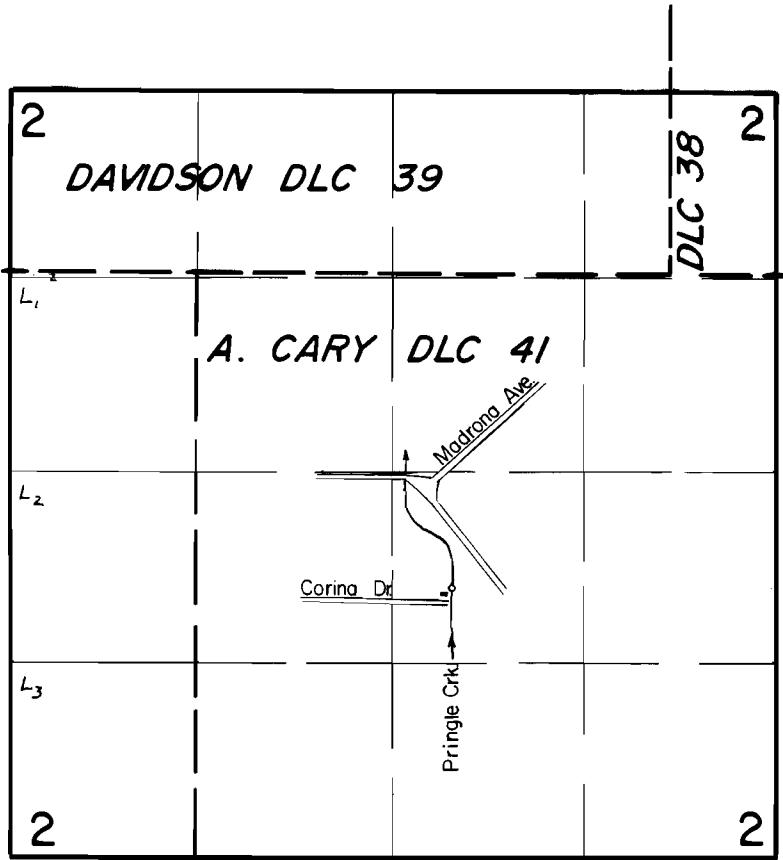

P.O.D. Loc. : 800' S. & 410' E. from C. 1/4. Sec. 2.

Scale : 1" = 1320'

FINAL PROOF SURVEY
UNDER

Application No. 6837.7... Permit No. 49390.....

IN NAME OF

FRANCIS P. SCHOMUS

Surveyed April 29, 1986., by T. Warren.....

41047-278-17R
+ ZOOM
TMW