


T. 5 S., R. 1 E., W.M.

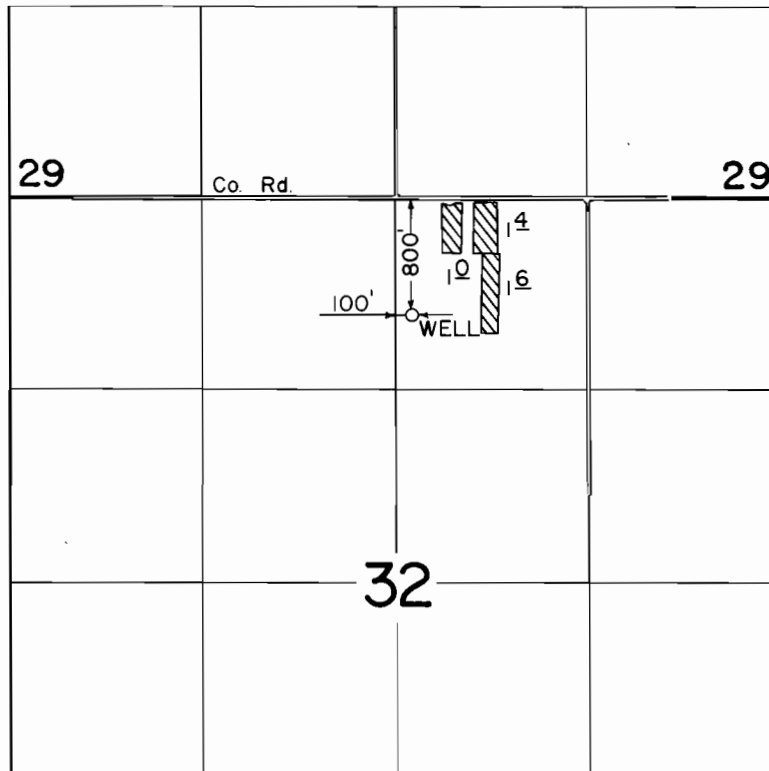

SCALE: 1" = 1320'

FINAL PROOF SURVEY

UNDER

Application No. G-6566 Permit No. G-6167.....
IN NAME OF

.....GREGORY SANAROV.....

Surveyed JUNE 24, 1985., by T. WARREN.....