


T.5S. R.1W., W.M.

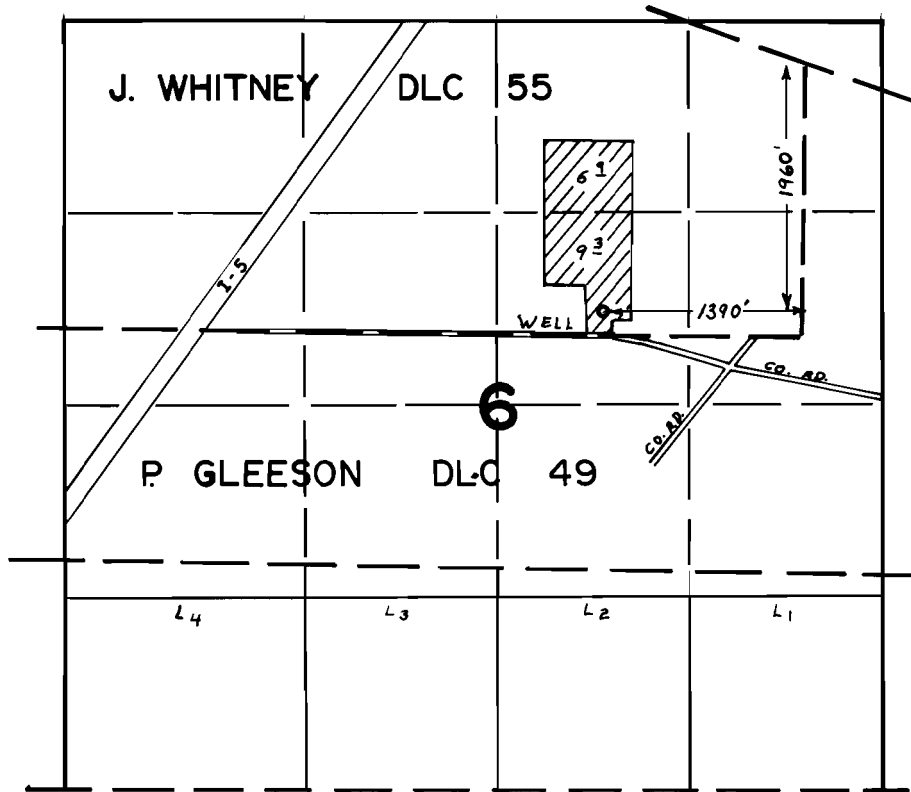

FINAL PROOF SURVEY UNDER

Application No. G-6860... Permit No. G-6399...
IN NAME OF

.....STEPHEN D. COLEMAN.....

Surveyed JUNE 8... 1979., by L. H. NUNN.....