


T.15S., R.6W., W.M.

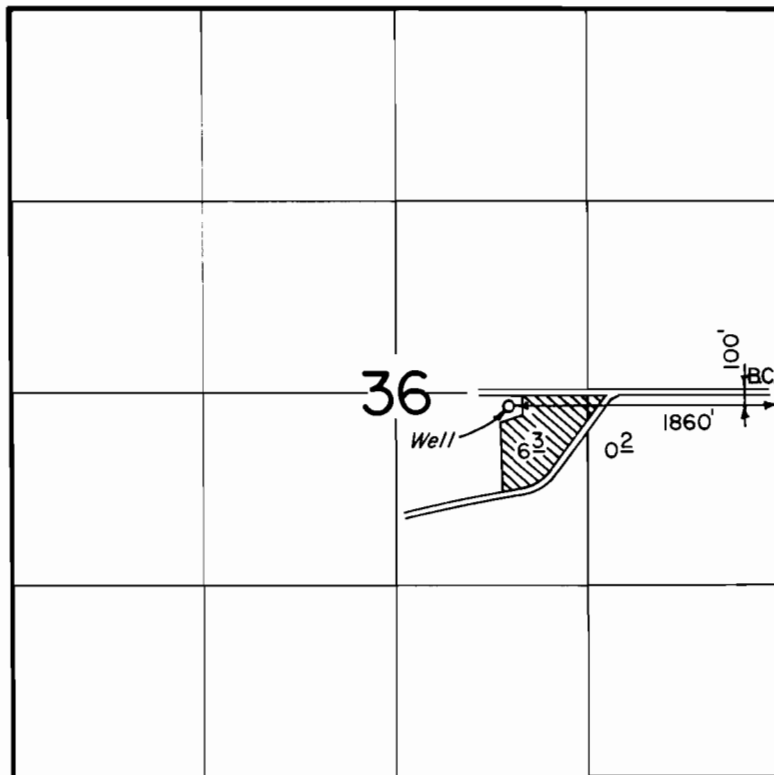

FINAL PROOF SURVEY
UNDER

Application No. G-6962 Permit No. G-6474

IN NAME OF

B. L. & V. McFADDEN, JR.

Surveyed MAY 7, 1980, by *dBrown*