


G- 6847
56689

T. 6 N. R. 36 E. W. M.

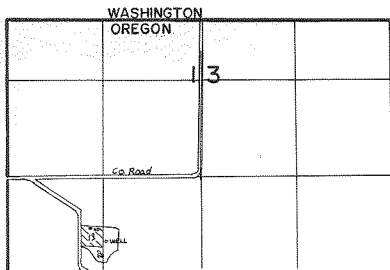

SCALE 1" = 1320'



WELL LOC. 880' S. & 40'E. from NW Cor. SE 1/4 SW 1/4 Sec. 13

FINAL PROOF SURVEY UNDER

Application No. G-6573, Permit No. G-6847...
IN NAME OF

HARRY W. HOUGHIN

Surveyed 4-24 1984, by V.L. CHURCH

REV 4/2/87 SC
378-258A J6

BASIN 7 wells