


G.6980  
T837D  
56690  
76483

# T.26S. R.15E. W.M.

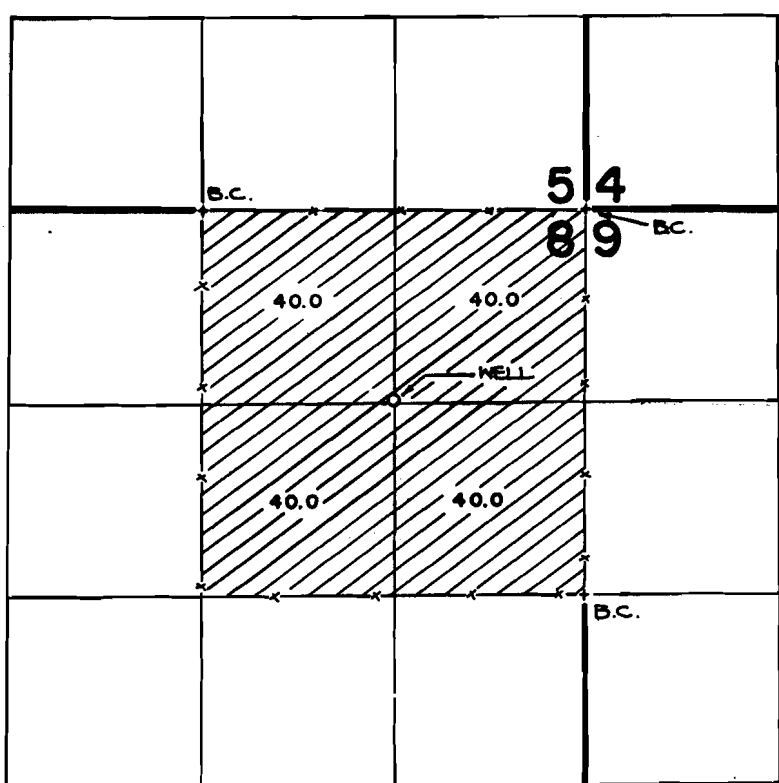

THE WELL IS LOCATED 1310 FT. S. AND 1320 N. FROM THE N.E. CORNER OF SECTION 8.



SCALE: 4" = 1 MILE

## FINAL PROOF SURVEY UNDER

Application No. G-7500. Permit No. G-6980....  
IN NAME OF

.....RICHARD...N...WIDENOJA.....

Surveyed OCT. 15... 1984, by P. P. Patten.....