


T.6S., R.2W., W.M.

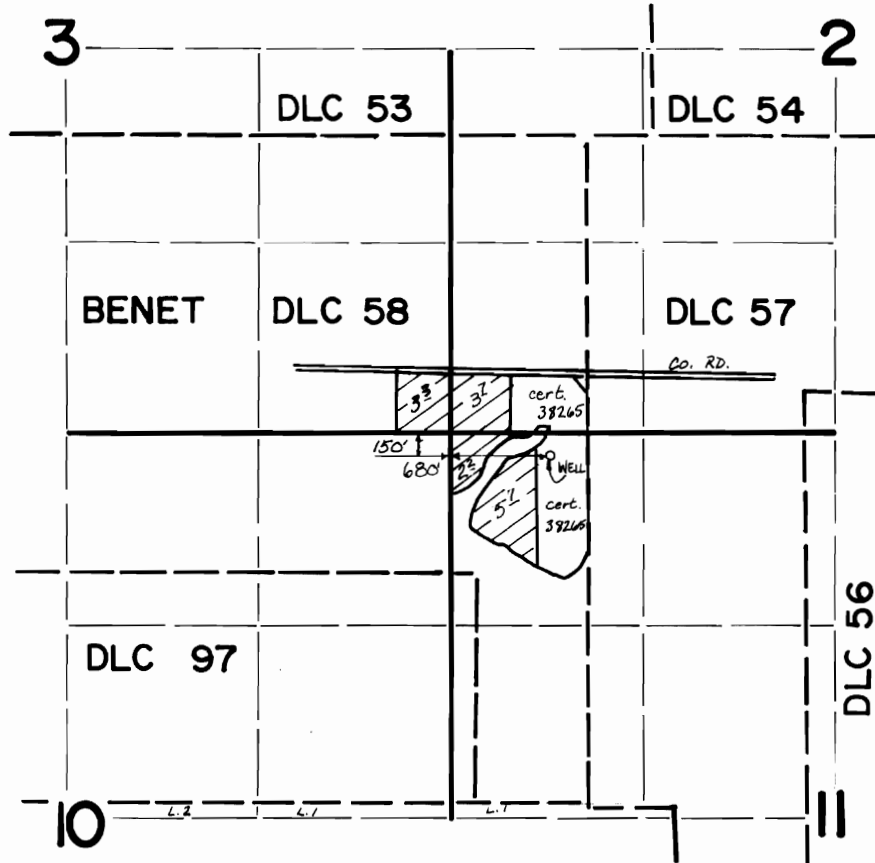

FINAL PROOF SURVEY UNDER

TRANSFER 5018

Application No. G.7670... Permit No. G.7107.....

IN NAME OF

SCHLECTER

Surveyed OCT. 26... 19.83., by M. CAHILL.....