


T.17S.,R.5W.,W.M.

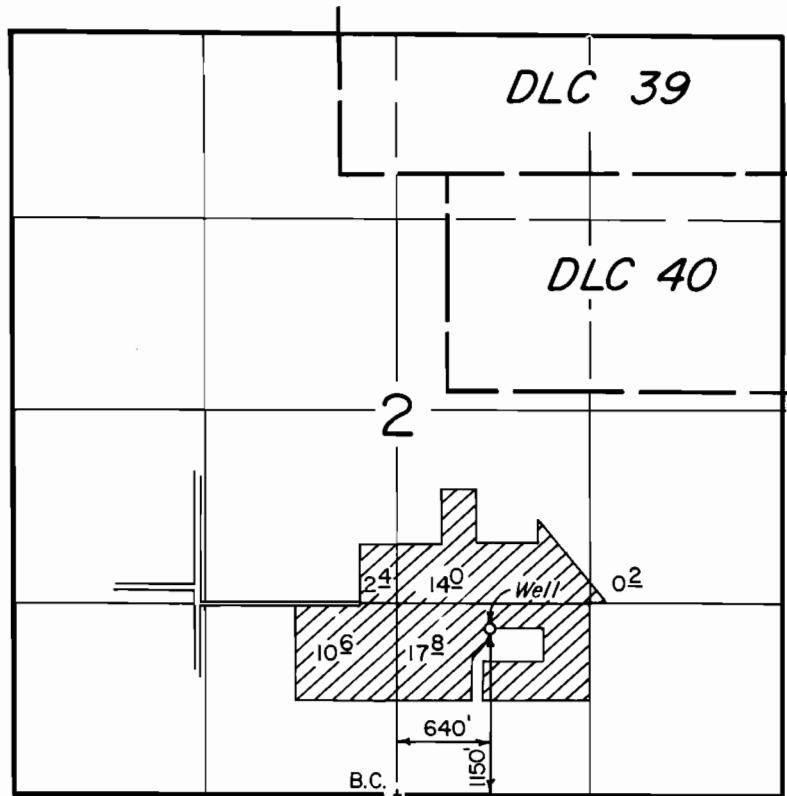

FINAL PROOF SURVEY
UNDER

Application No. G-7858 Permit No. G-7284...

IN NAME OF

JOHN R. RATLIFF, JR.

Surveyed MAY 6, 1980, by *St. Brown*.....