


T.17S. R.3W. W.M.

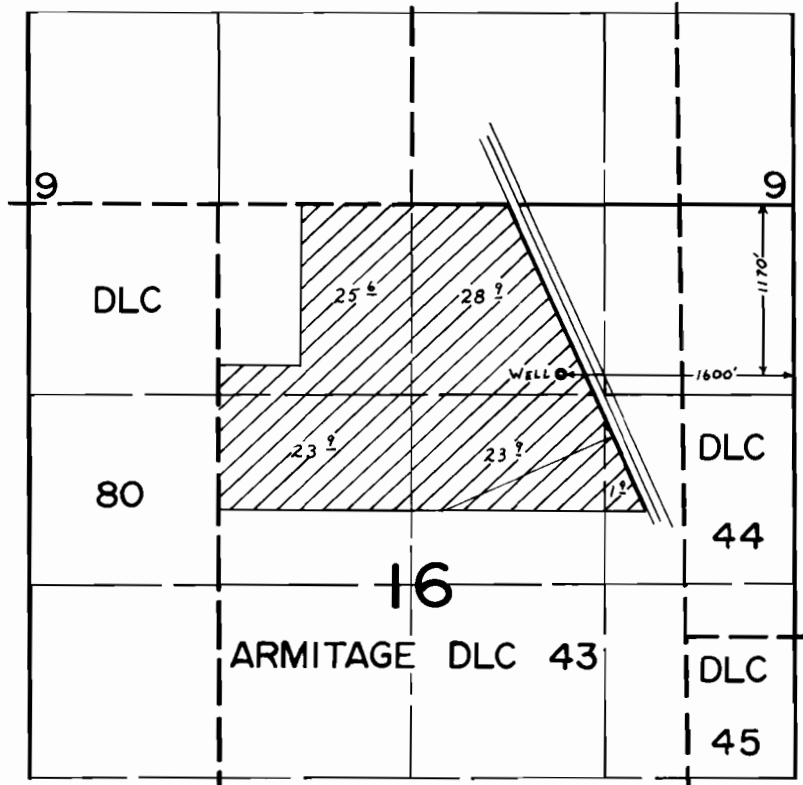

FINAL PROOF SURVEY
UNDER

Application No. G-7871. Permit No. G-7292
IN NAME OF

EDWIN E. CONE

Surveyed June 20, 1980, by C. L. Hughes