


# T.5S. R.1W., W.M.

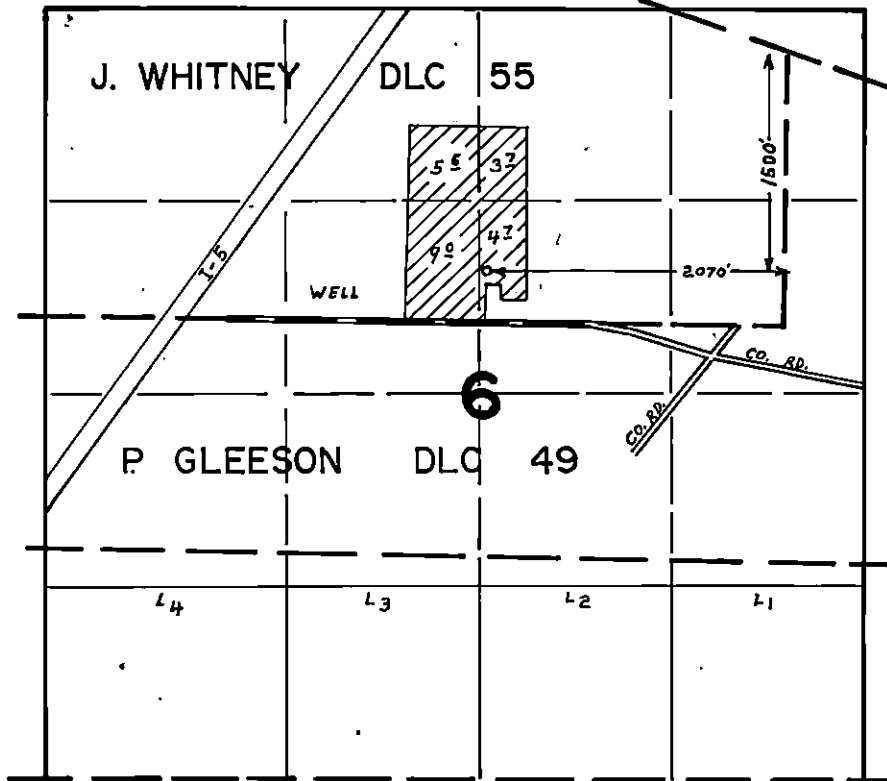

## FINAL PROOF SURVEY UNDER

Application No. G-8970... Permit No. G-8340...  
IN NAME OF

JACK & ALICE HUNT

Surveyed JUNE 8 1979, by L.H. NUNN