


T.6S.,R.1E.,W.M.

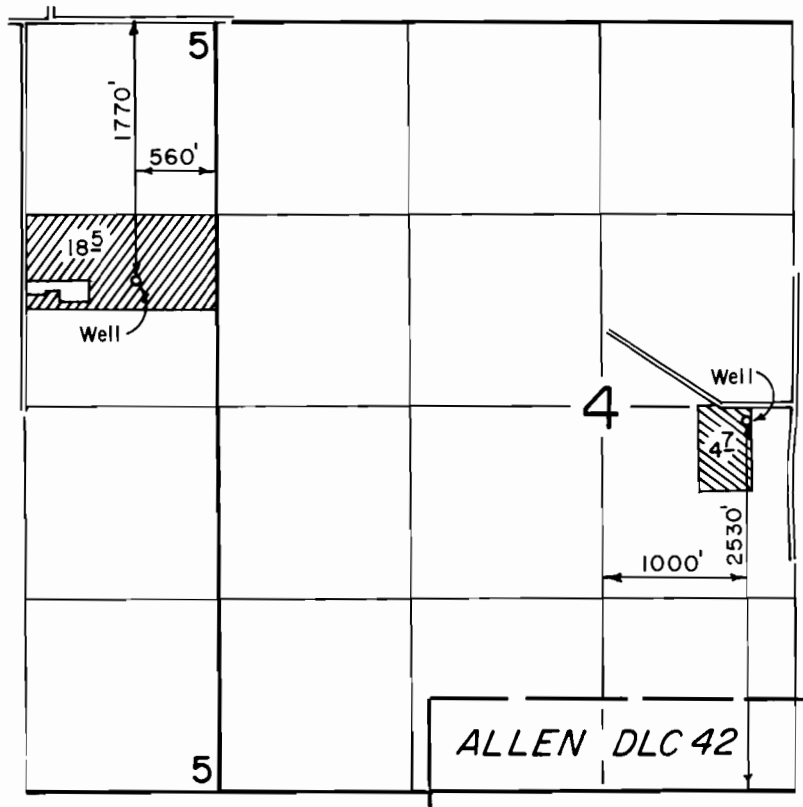

FINAL PROOF SURVEY
UNDER

Application No. G-9058 G-8394
G-9059 Permit No. G-8395
IN NAME OF

IVAN GOUSLIKOFF

Surveyed MAY 19, 1980, by *St. Brown*