




T. 1 S., R. 3 E., W.M.

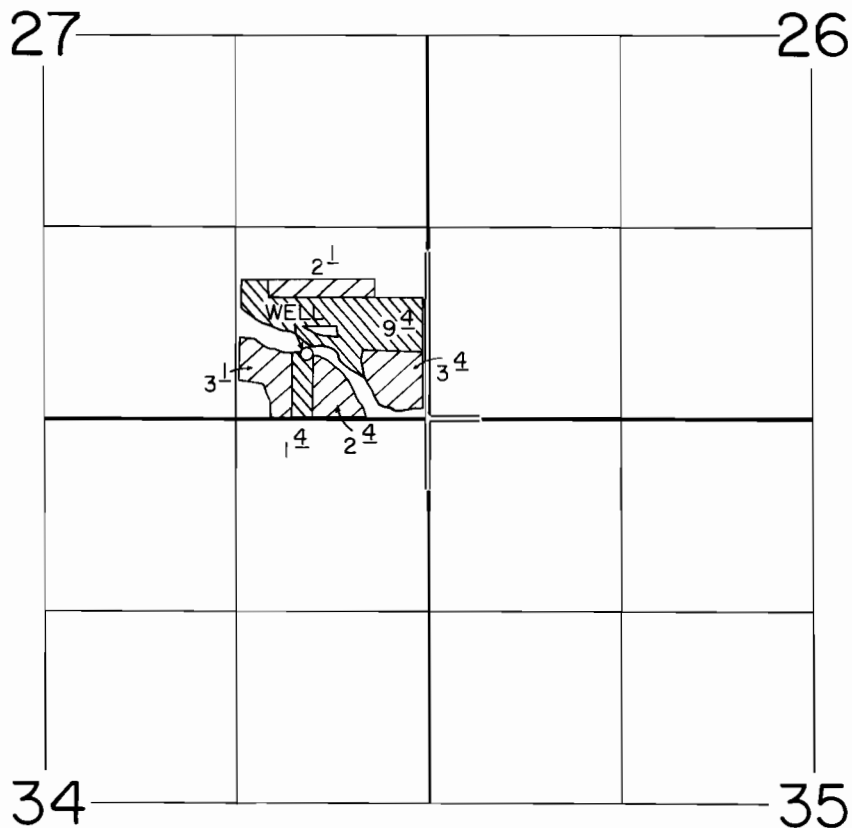

WELL LOC: 450' N. & 840' W. FROM SE CORNER SECTION 27

SCALE: 1" = 1320'



Containerized Nursery Stock

In-Ground

FINAL PROOF SURVEY

UNDER

Application No. G-9973 Permit No. G-9004....

IN NAME OF

ROBERT E. FURNEY

Surveyed OCT. 9..... 1986., by T. WARREN.....