


T. 9S., R. 39E., W.M.

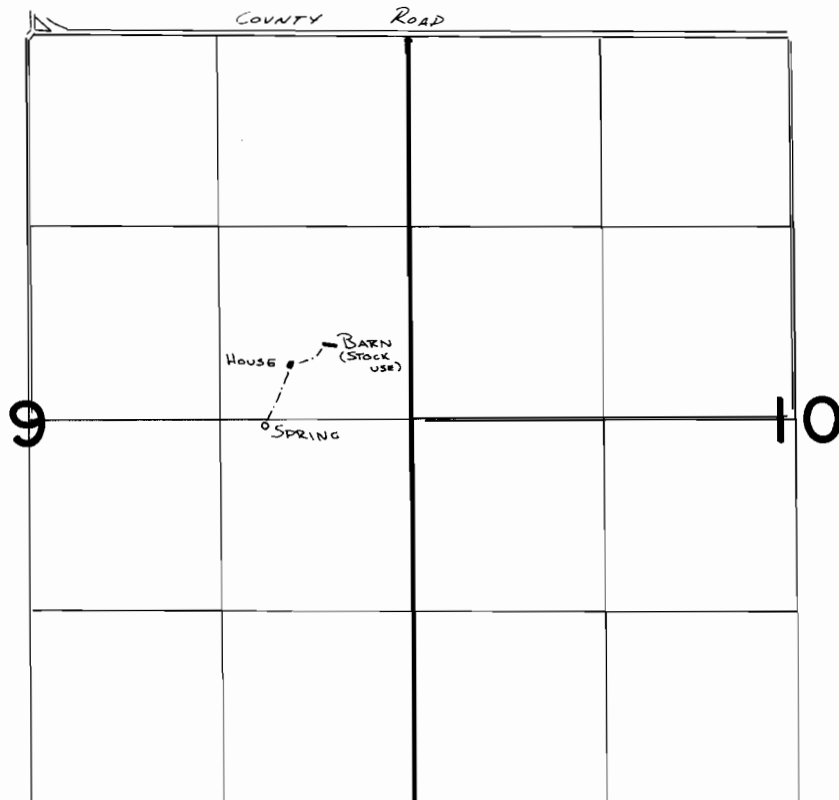

SCALE 1" = 1320

SPRING LOC: 40'S. & 1000'W. FROM E 1/4 COR. SEC. 9

FINAL PROOF SURVEY

UNDER

Application No. **42368** Permit No. **32261**.....
IN NAME OF

LLEWELLYN & DARLENE ROBBINS

Surveyed 4-15..... 1987, by V.L. Church.....