


T. 4N., R. 5W., W.M.

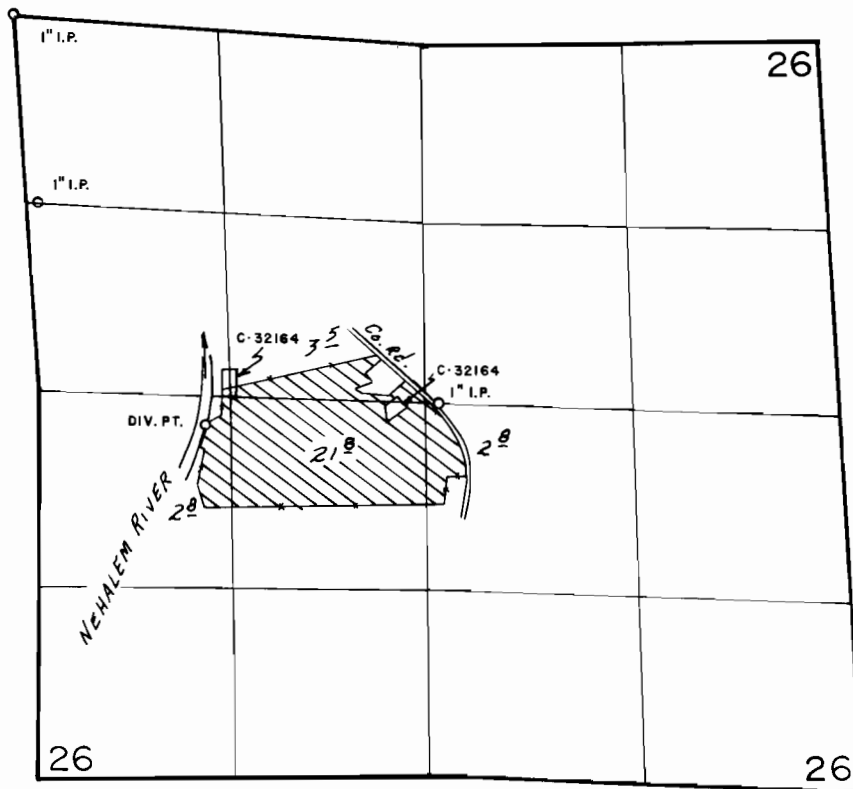

*Div. Pt. Loc.: 230'S. & 1140'E. FROM W. 1/4 COR. SEC. 26*

**FINAL PROOF SURVEY**  
UNDER

Application No. 43271... Permit No. 32343.....  
IN NAME OF

CARL & PEARL E. SELANDERS.....

Surveyed AUG. 30, 1977, by S. C. BROWN.....  
JUNE 2, 1980, R. G. MUCKEN

PTS-1977-L  
PTS-1980-H-3  
BMB