


T.5N.R.2W.W.M.

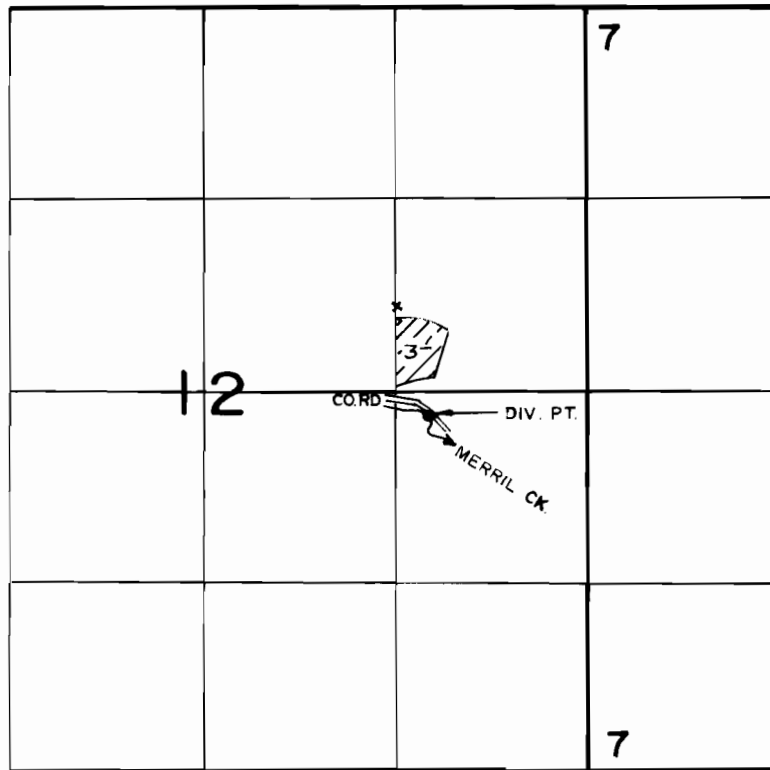

DIV. PT. LOC.: 170' S. & 220' E. FROM C.E. 1/16 SEC 12

FINAL PROOF SURVEY UNDER

Application No. 46941 Permit No. 35132.....
IN NAME OF

.....EUGENE D. FROST.....

Surveyed APRIL 10, 1980, by R.G. MUCKEN.....