


T.IOS. R.IOW. W.M.

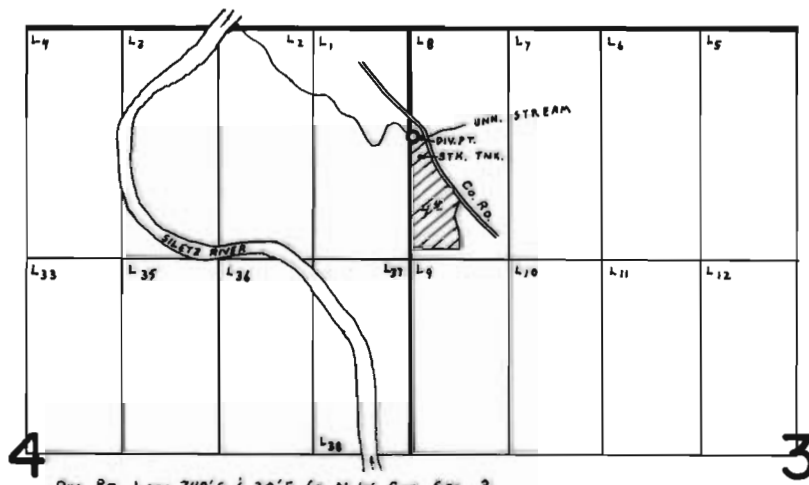

Div. Pt. Loc: 740'S. & 30'E. fr. N.W. Cor. SEC. 3.

FINAL PROOF SURVEY UNDER

Application No. 48731. Permit No. 36555.
IN NAME OF
DAVID B. & LAURENE EASTHAM
CARL & MARY E. TOWNE

Surveyed June 13, 1979, by C. L. HUGHES.