


T.IOS. R.IIW. W.M.

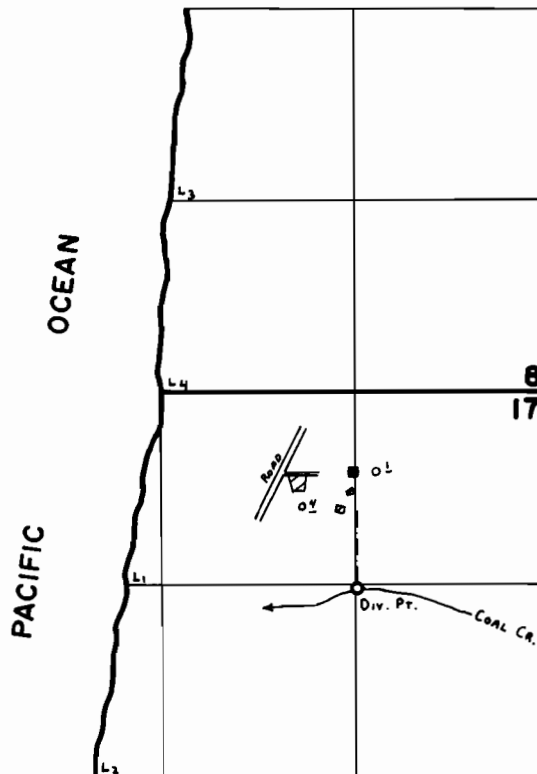

DIV. PT. Loc: 25'S. & 5'E. fr. N.W. Cor. SE $\frac{1}{4}$ NE $\frac{1}{4}$ SEC 17.

FINAL PROOF SURVEY UNDER

Application No. 51578... Permit No. 38906...
IN NAME OF

FRANCIS L. HARDING

Surveyed June 14, 1979, by C. L. HUGHES...