


T.13S., R.1W., W.M.

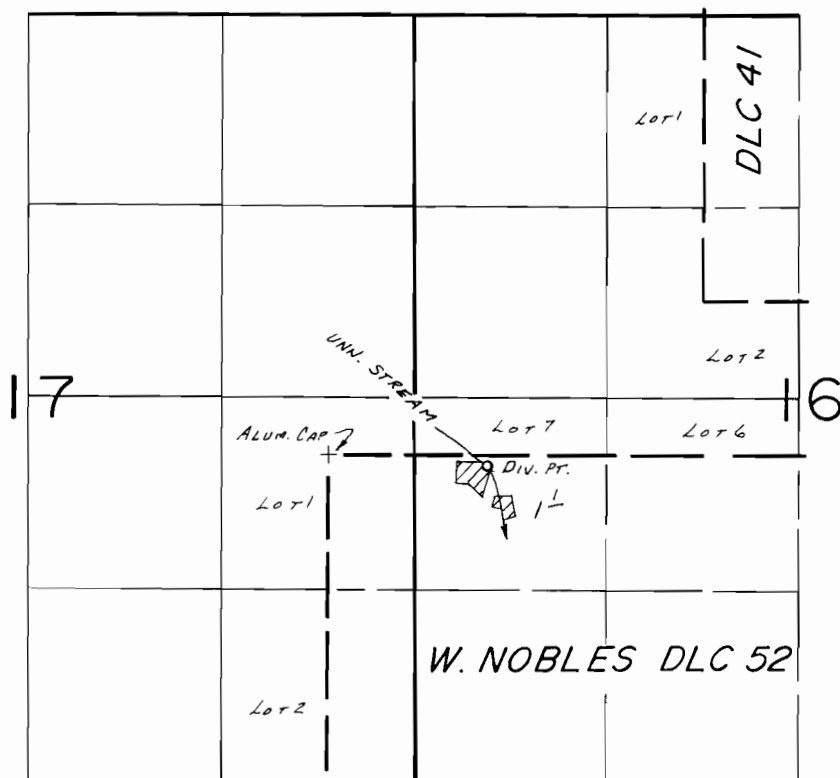

DIV. PT. LOC.: 70'S. & 1090'E. FROM NW COR. W. NOBLES DLC 52.

SCALE: 1"=1320'

FINAL PROOF SURVEY UNDER

Application No. 52239.. Permit No. 39318.....
IN NAME OF

.....ROSA LEE & DUDLEY E. CULPEPPER.....

Surveyed June 26, 1986, by B.W. BISHOP.....

11/20/86

BWB

PTS 1986 B